


T. 23 S. R. 32 E. W. M.

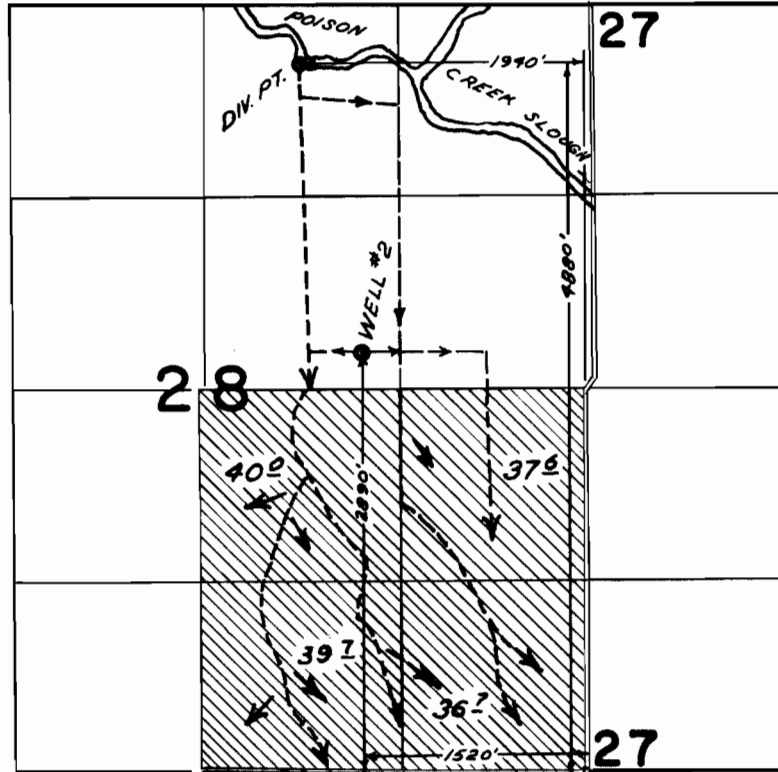

FINAL PROOF SURVEY
UNDER

Application No. G-1614 Permit No. G-1484
32729 25838

IN NAME OF

L. L. Jacobs

Surveyed SEP 12 1963, by C. BAKER
SEP 16 1965 C. GARDNER