


**T.40 S.R.3 W.W.M.**

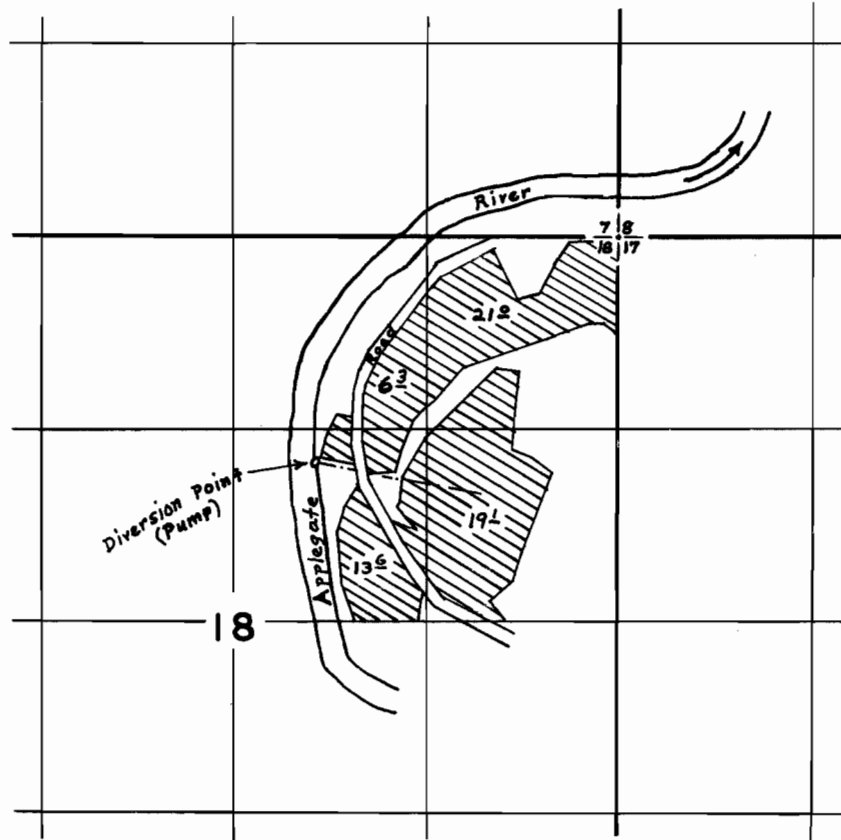

**FINAL PROOF SURVEY  
UNDER**

Application No. 31716 Permit No. 25005  
IN NAME OF

Morris & Hazel Byrne

Surveyed May 23 1963, by C Baker