


T.35S.R.3 & 4 W.W.M.

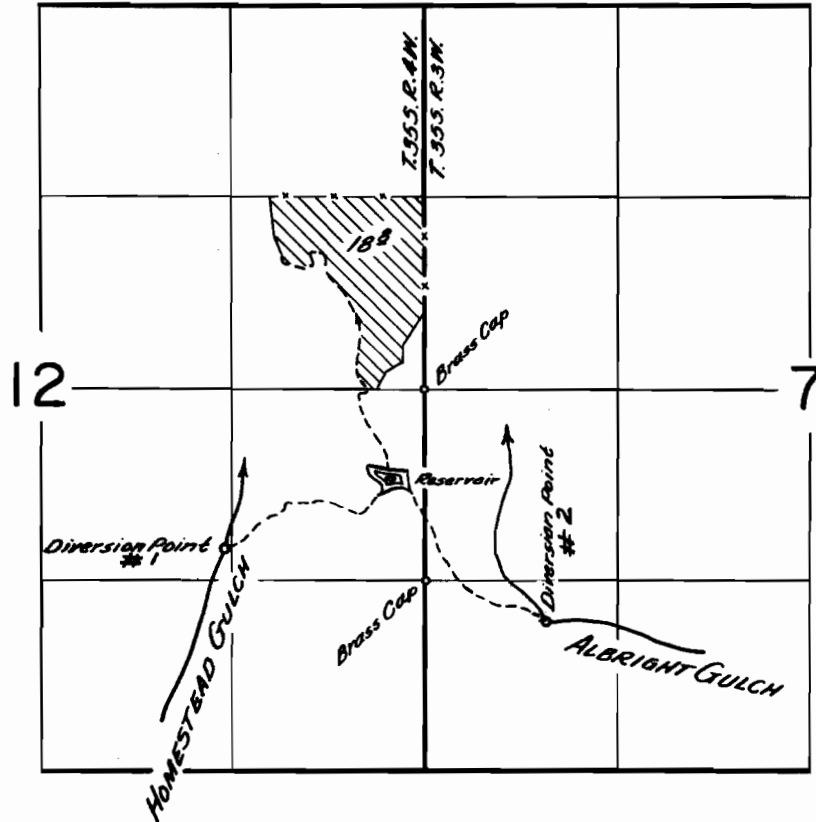

FINAL PROOF SURVEY
UNDER

Application No. R-33021 Permit No. R-2235
33022 26108
IN NAME OF

Eugene H. Moore

Surveyed July 10, 1963, by G. Baker