


T. 34.S.R.1.W.W.M.

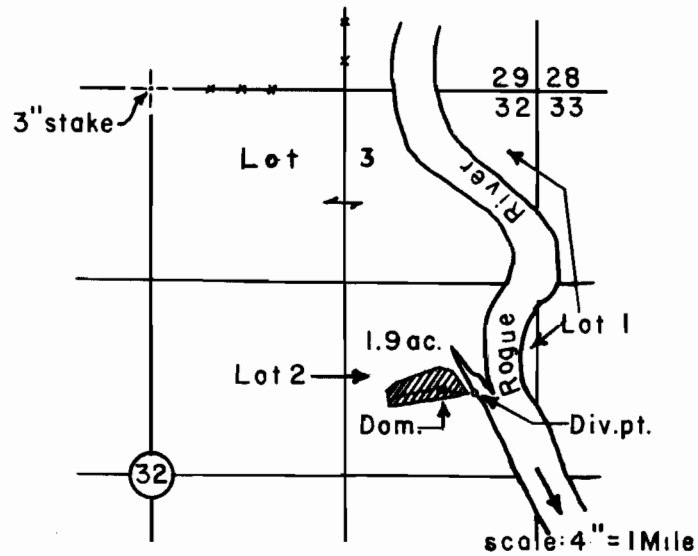

FINAL PROOF SURVEY UNDER

Application No. 33121 Permit No. 26330
IN NAME OF

Joseph H. and Helen P. Hicks.

Surveyed Aug. 12, 1965., by D.C. Hendrix