


T. 38 S.R.4 W. W.M.

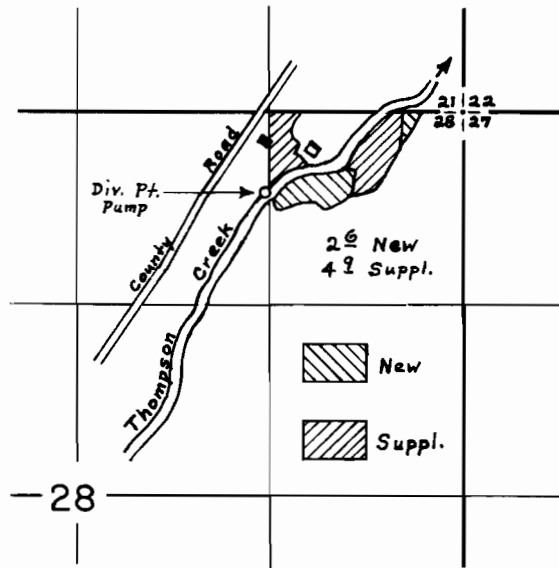

FINAL PROOF SURVEY UNDER

Application No. 34514 Permit No. 2710.9
IN NAME OF

John De Young

Surveyed March 25 1964, by David C. Hendrix