


T.38 S.R.4.W.W.M.

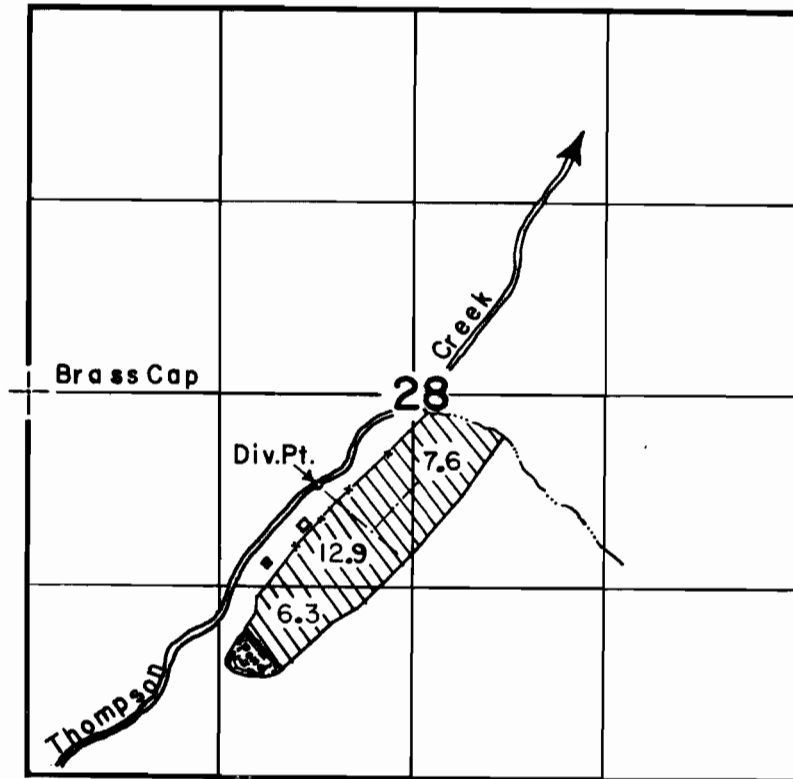

FINAL PROOF SURVEY UNDER

Application No. 34594..... Permit No. 27165.....
IN NAME OF

.....Ada V. Teske.....

Surveyed Mar.22... 1966., by D.C.Hendrix.....