


T.35S.R1W.W.M.

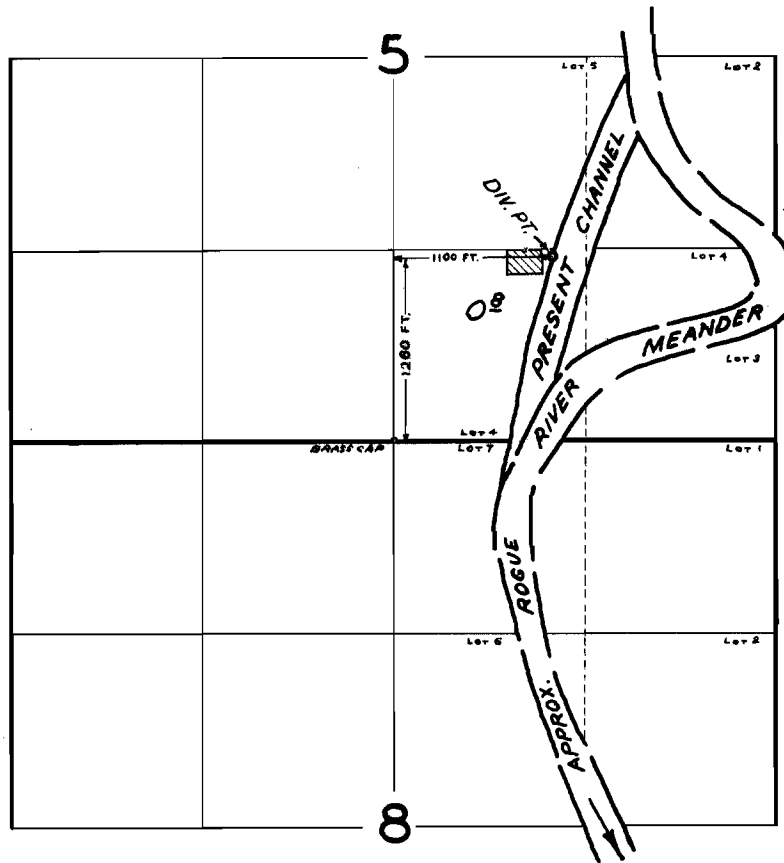

FINAL PROOF SURVEY
UNDER

Application No. 37092 Permit No. 27611

IN NAME OF

JACK INGRAM

Surveyed JUL 15 1965 by C. GARDNER