


T.33S.R.2E.W.M.

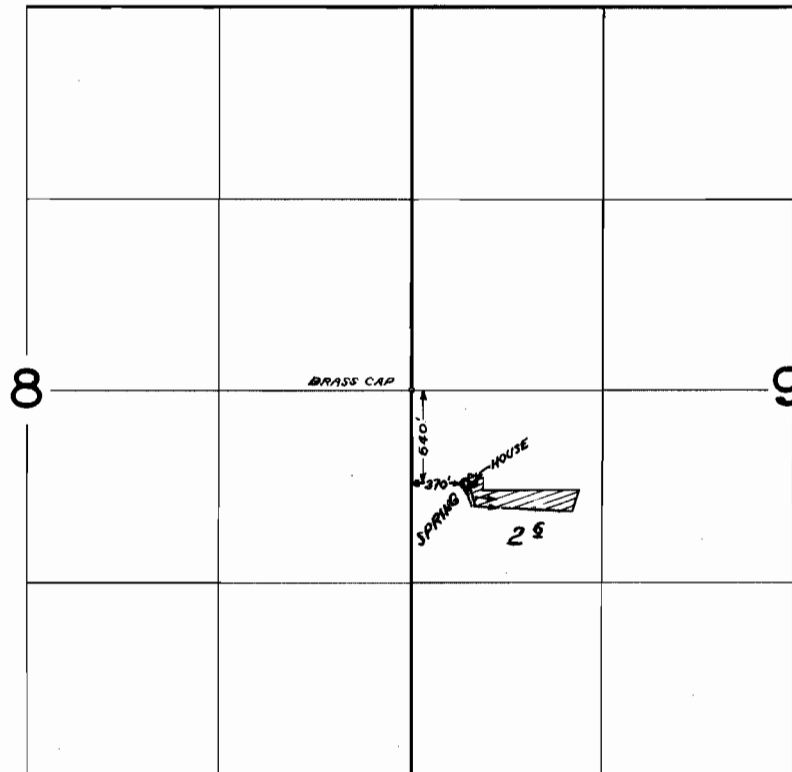

FINAL PROOF SURVEY
UNDER

Application No. 37963 Permit No. 28312
IN NAME OF

JOE W. & MABEL J. JOHNSON

Surveyed Jul. 22 1965, by C. GARDNER