


T. 37S. R. 5 W.W.M.

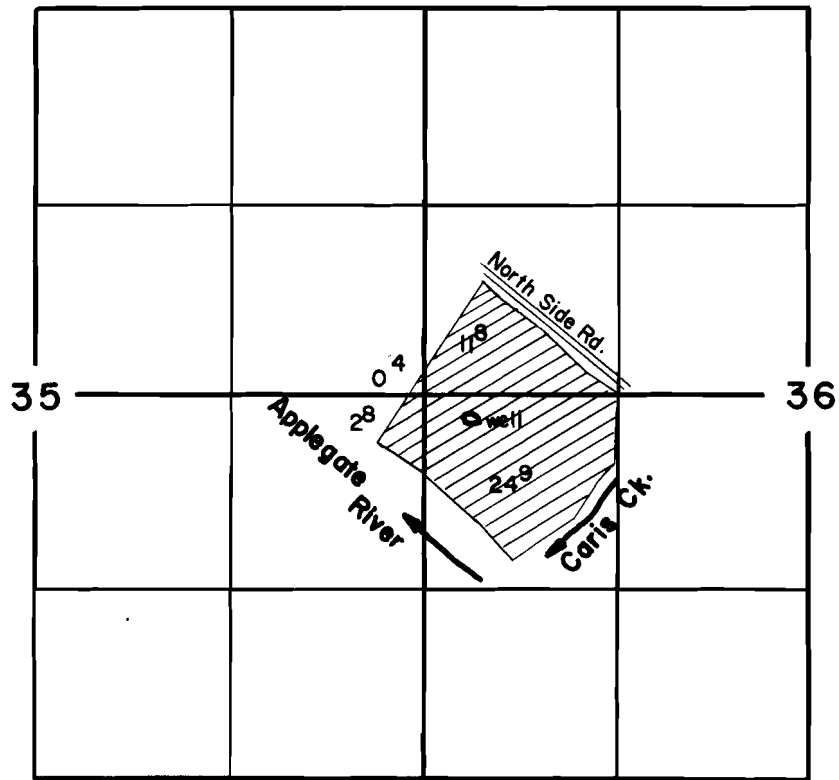

FINAL PROOF SURVEY
UNDER

Application No. G-1942 Permit No. G-1785
IN NAME OF

.....LLOYD H. PALMERTON.....

Surveyed April 27 1965, by R. B. Stalmer...