


T. 40S.

R. 8W.

R. 7W.

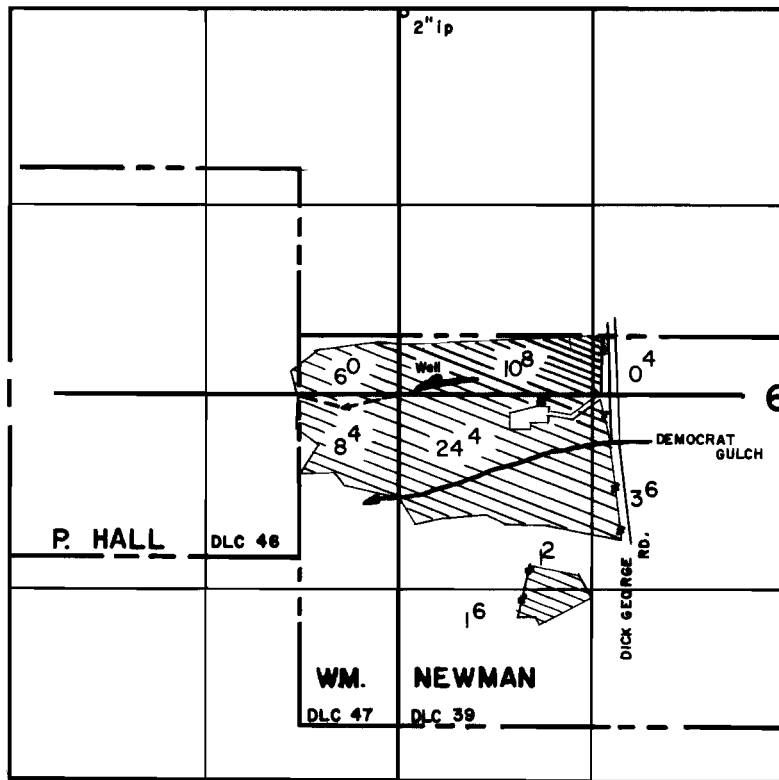

FINAL PROOF SURVEY
UNDER

Application No. G-2204 Permit No. G-2026
IN NAME OF

..... J. S. TELLVIK

Surveyed Feb. 3, 1965, by R. B. Steimer.....