


T. 39 S. R. 8 W.W.M.

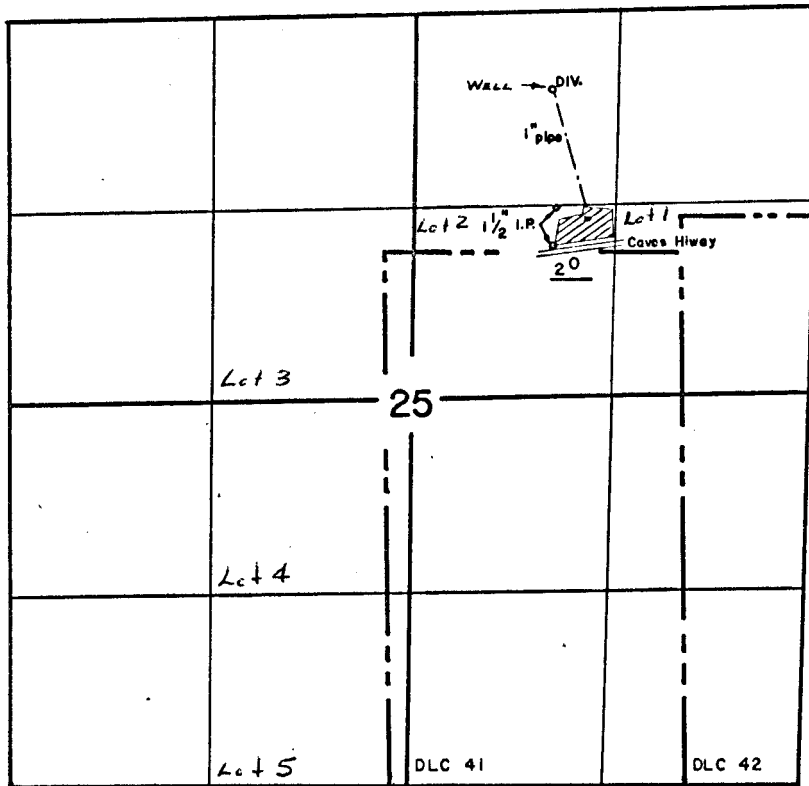

FINAL PROOF SURVEY UNDER

Application No. G-2408. Permit No. G-2257.
IN NAME OF

.....JOHN W. & GLADYS T. ENGLAND.....

Surveyed May 12, 1965., by R. B. STEIMER