


T.36S.R.6W.W.M.

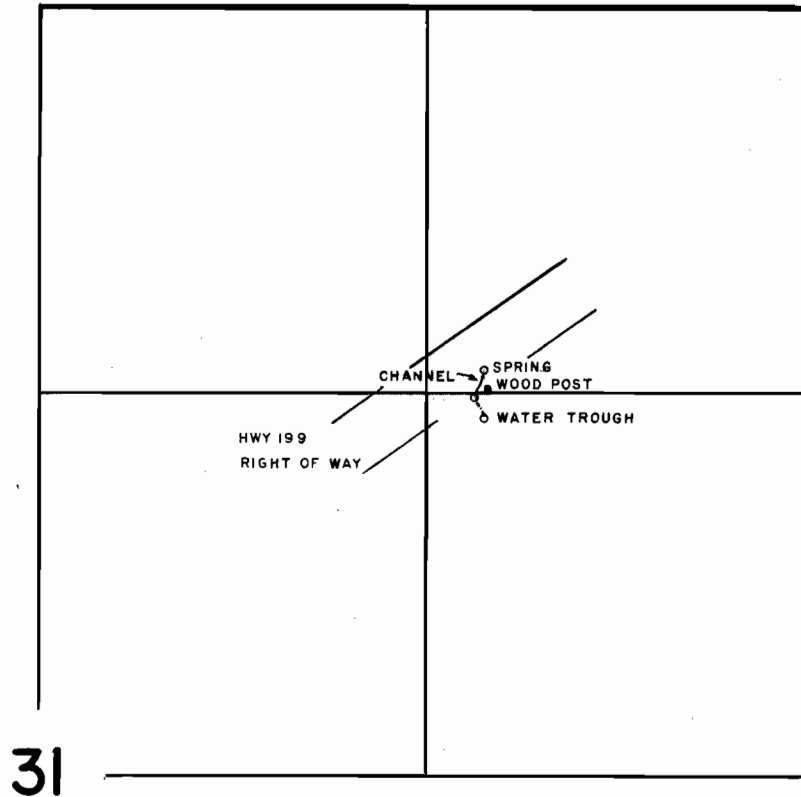

SCALE 8" = 1 MILE

FINAL PROOF SURVEY
UNDER

Application No. 32953 Permit No. 26042
IN NAME OF

WILLIAM J. SPRATLING

Surveyed DEC 10 1965, by R. B. STEIMER