


T.40S.R.8W.W.M.

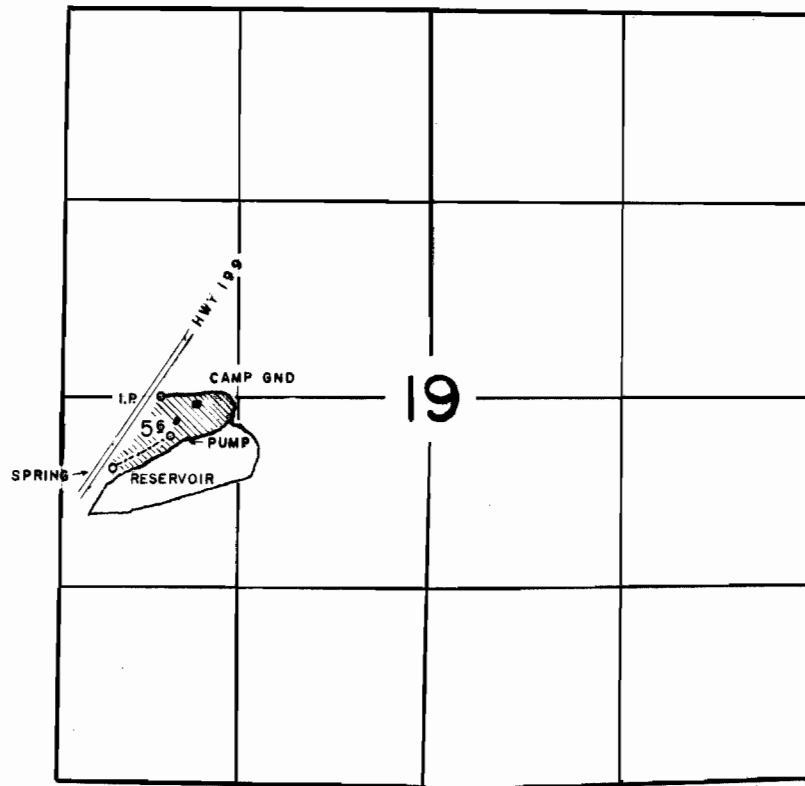

FINAL PROOF SURVEY
UNDER

Application No. 37092... Permit No. 27655...
IN NAME OF

.....**CHARLIE A. TREFETHEN**.....

Surveyed Oct. 21... 1964, by R.B. STELMER..