


T. 34S. R. 7 W. W. M.

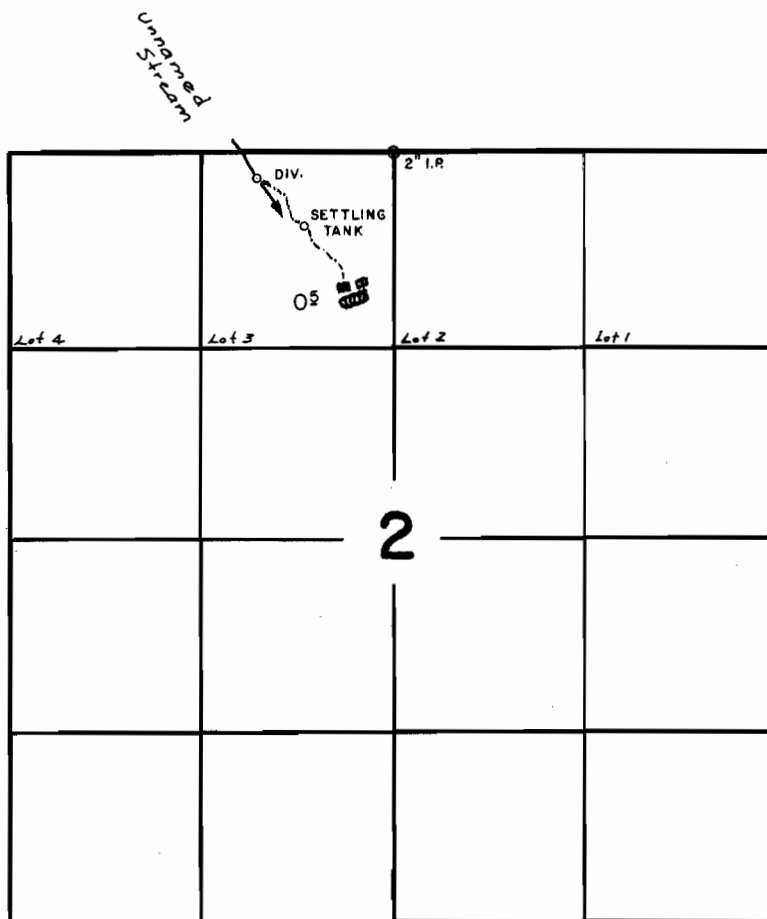

FINAL PROOF SURVEY UNDER

Application No. 37217..... Permit No. 27734.....
IN NAME OF

JOHN B. H. WICKERSHAM

Surveyed OCT 26 1965, by R. B. STEIMER