G-350
33169
80694

Sycan River in Sycan Marsh wells

T.36 S. R.12 E.W.M.

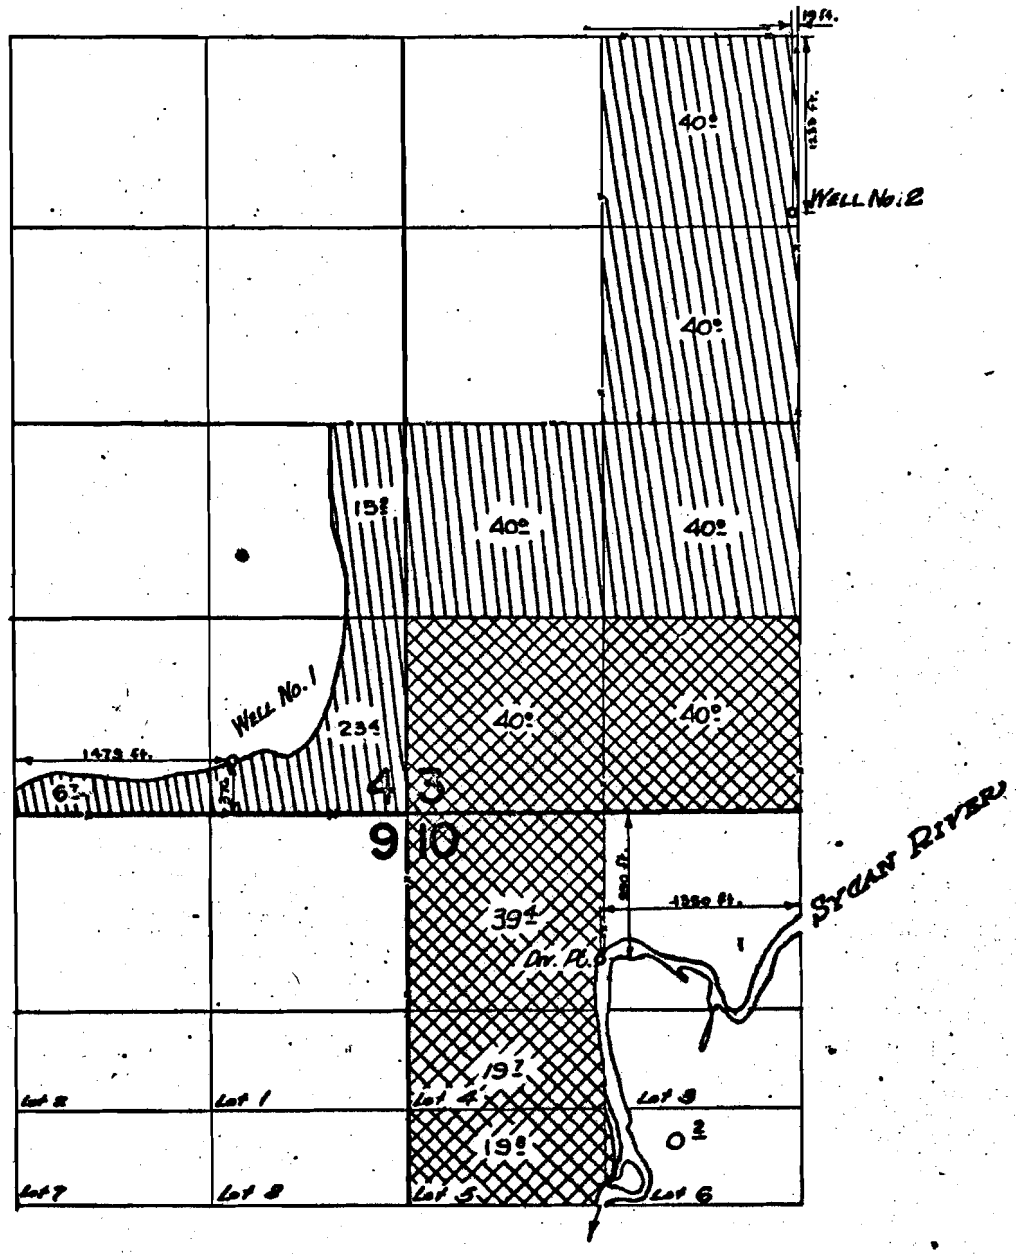

FINAL PROOF SURVEY
UNDER

33991 — G-1752 — 26784 — G-1602

Application No. G-472 . Permit No. G-350

IN NAME OF

THOMAS & VIOLA H. PLEMONS

WALLACE & LAWRENCE PLEMONS

Surveyed May 26, 1964, by R. Jackson