



T.37S.R.9E.W.M.

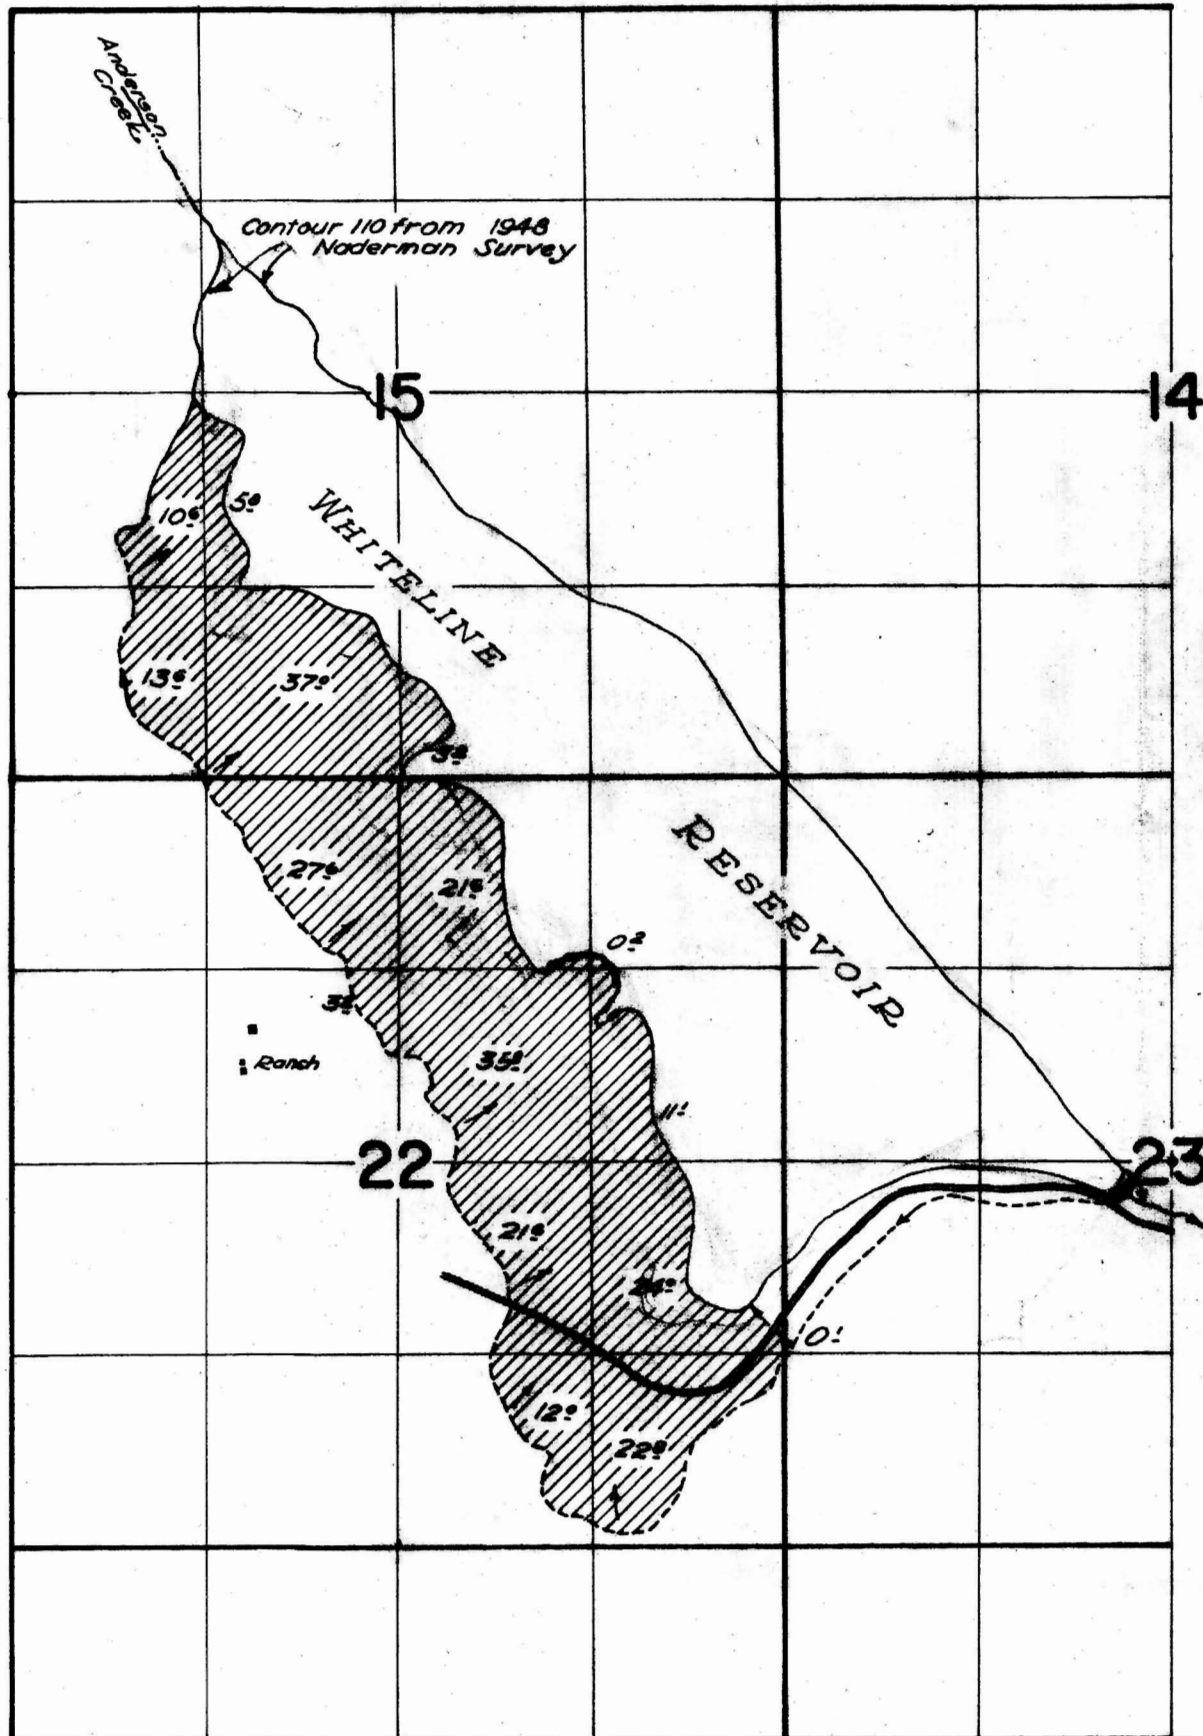

T.37S.R.10E.W.M.

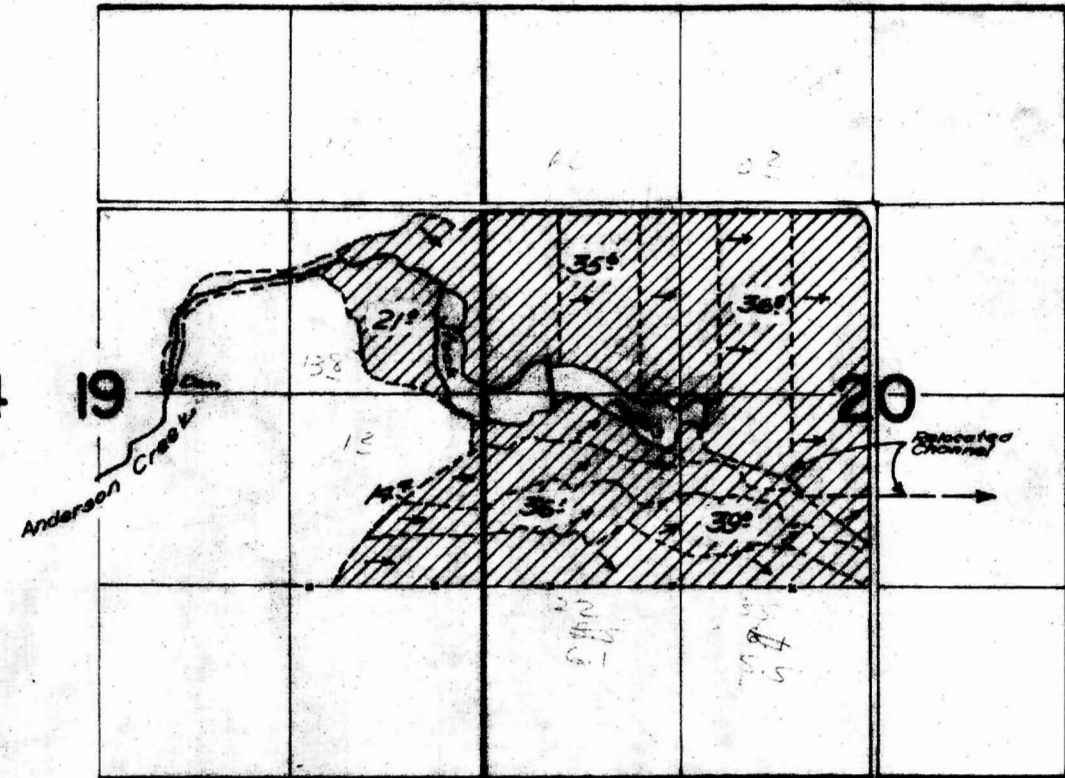

FINAL PROOF SURVEY UNDER

Application No. 19705	Permit No. 15316
R-20521	R-801
20522	16023
24201	19083
27322	21482

IN NAME OF

H. Douglas Whiteline

Surveyed June 15 1961 by *H. Douglas Whiteline*