



T.37 S.R.9 E.W.M.

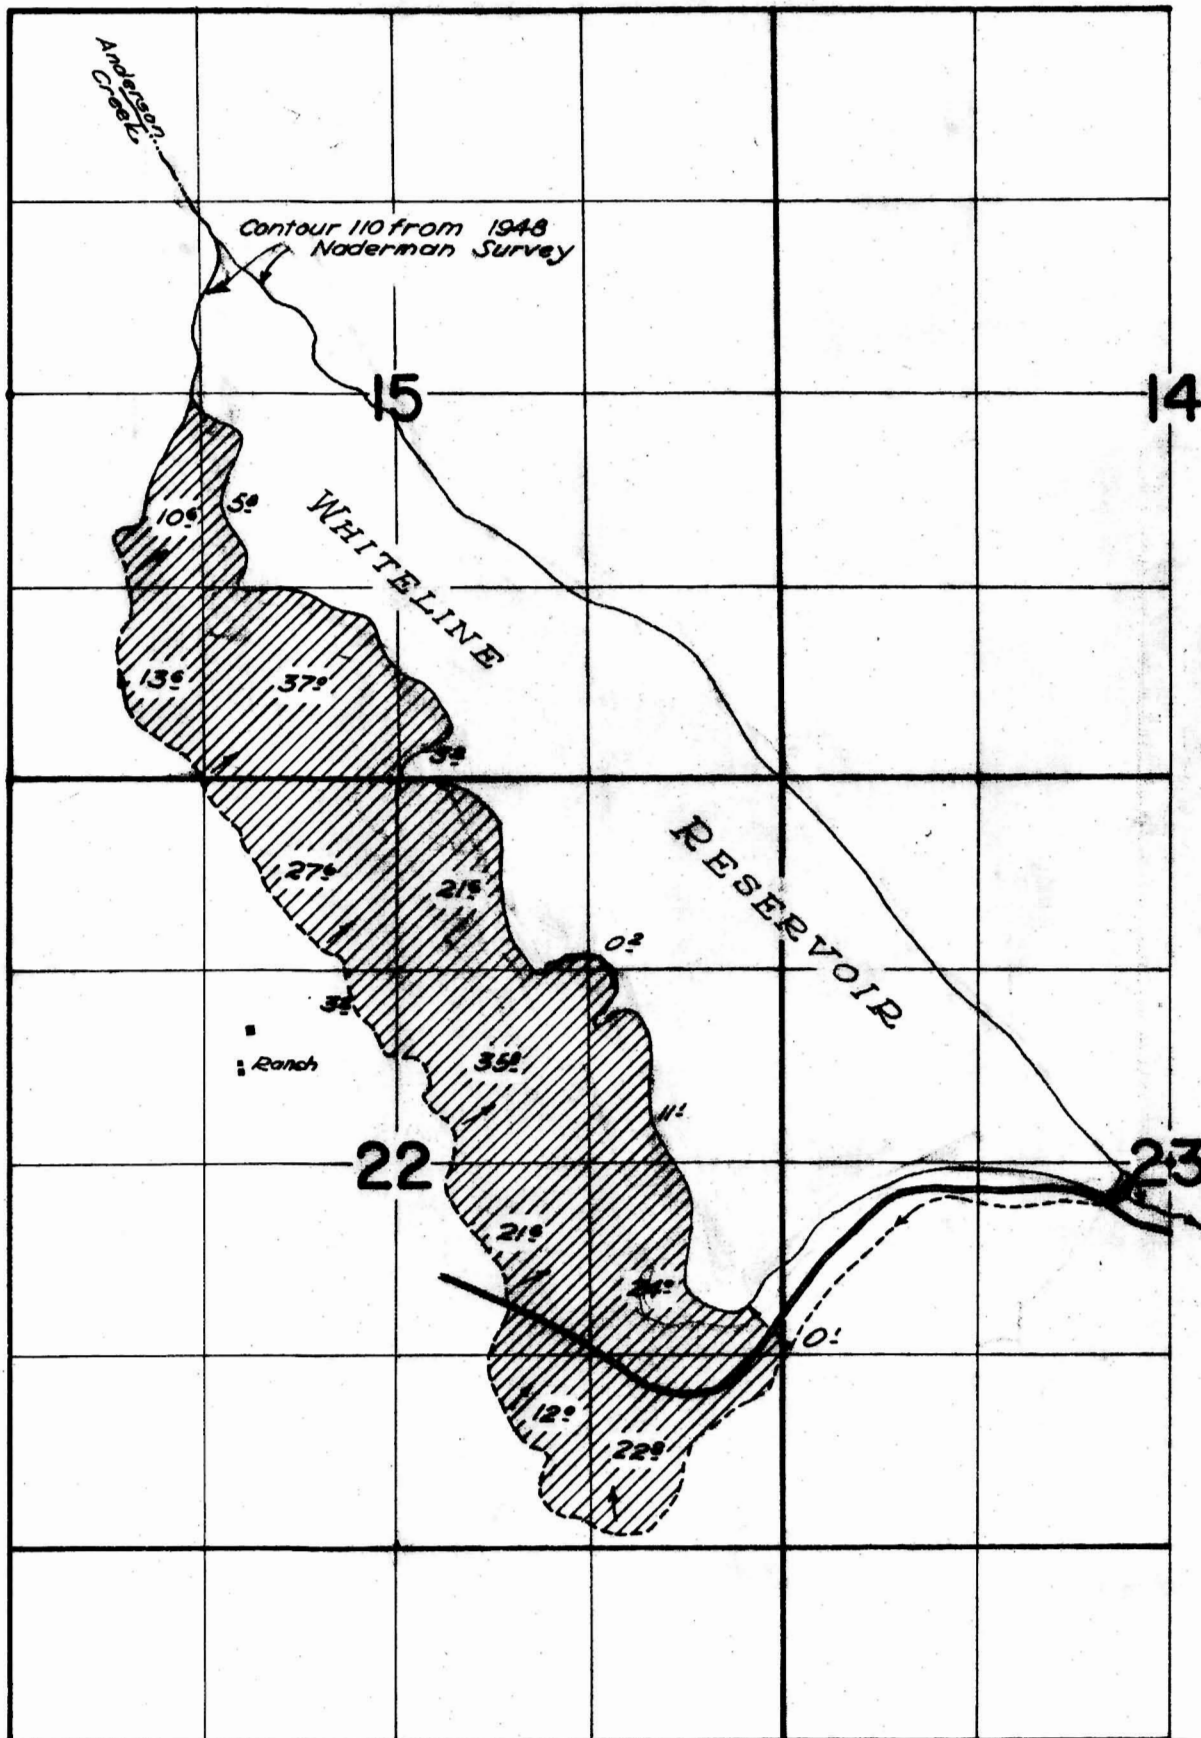

T.37S.R.10E.W.M.

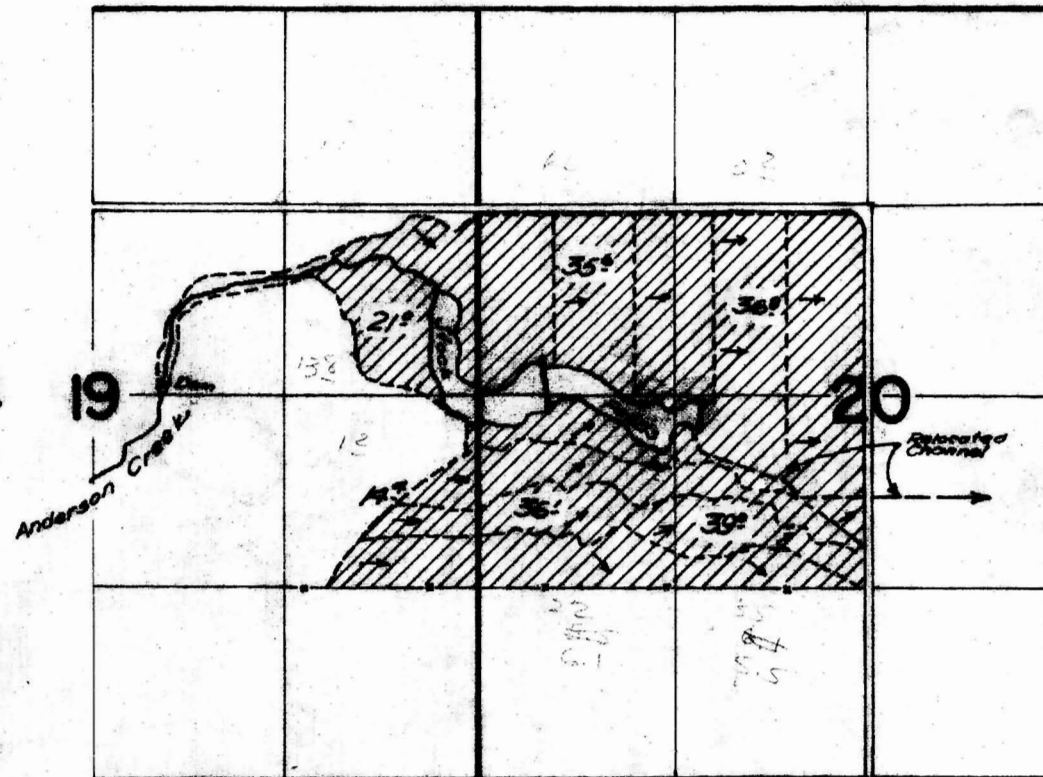

FINAL PROOF SURVEY

UNDER

Application No.	19705	Permit No.	15316
	R-20521		R-501
	20522		16023
	24201		19053
	27322		21482

IN NAME OF

H. Douglas Whiteline

Surveyed June 15 1961 by *H. Jackson*