


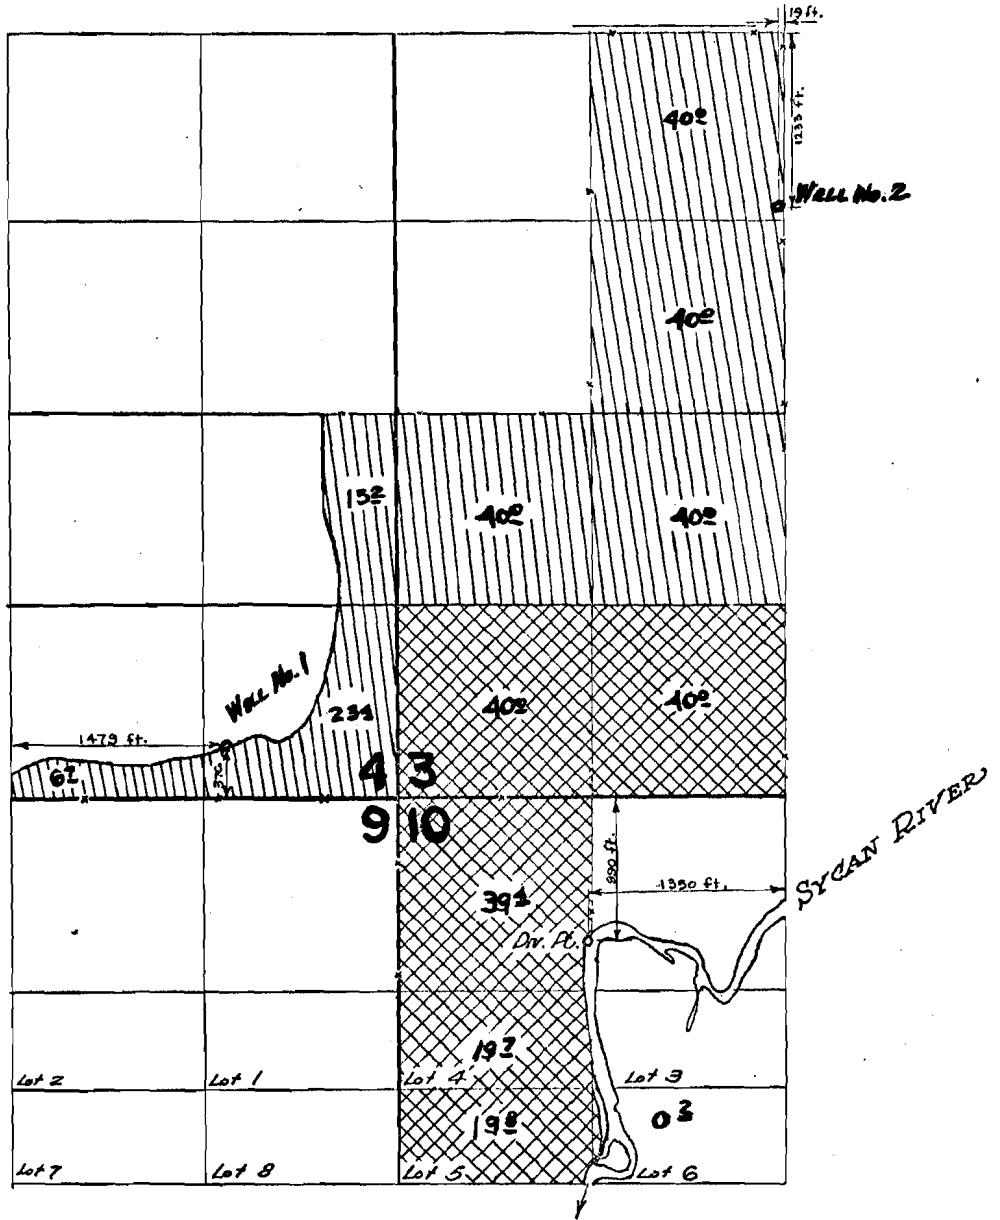


T.36S.R.12E.W.M.

Sycan Riv. below Sycan marsh



FINAL PROOF SURVEY
UNDER

33991 26784 
 G-1752 G-1602 
 Application No. G-472 Permit No. G-350 

IN NAME OF
THOMAS & VIOLA H. PLEMONS
WALLACE & LAWRENCE PLEMONS

Surveyed *May 26, 1964*, by *L. Jackson*