
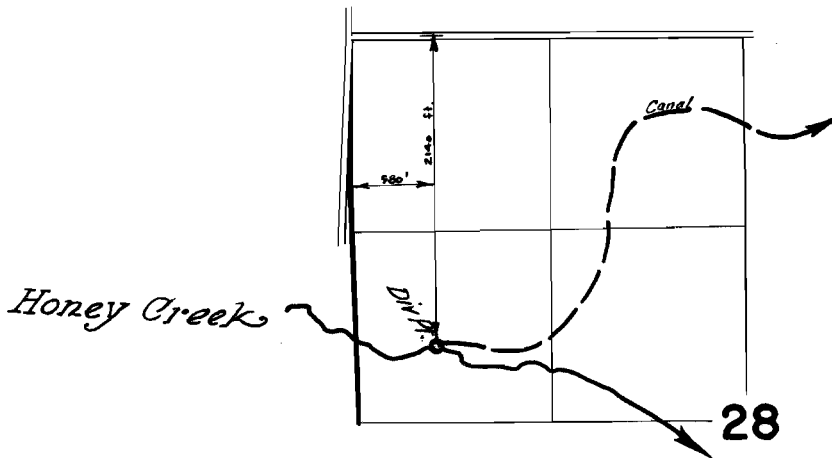


T.36S.R.24E.W.M.

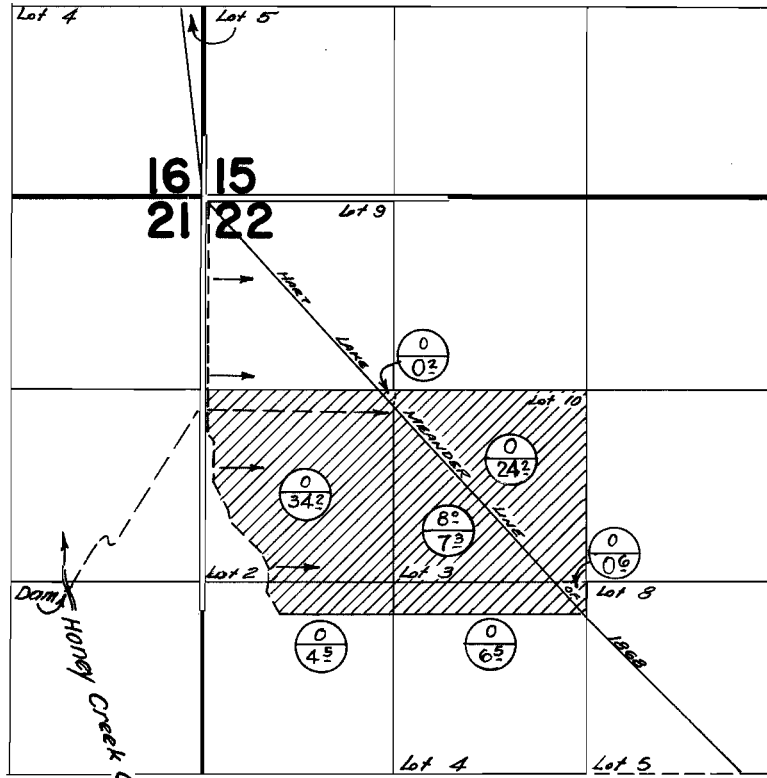

FINAL PROOF SURVEY UNDER

Application No. **32842** Permit No. **25945**
IN NAME OF

Donald J. & Cornelius Fitzgerald Jr.

Surveyed *Sept. 14* 1962, by *R. Peterson*