

33180


6 18 27 21 29 34 25 40 40 39 12 37 30 1 12

Goose Lake Mauder Line

Thomas Creek

Protracted lines of Sections 7 & 8

78

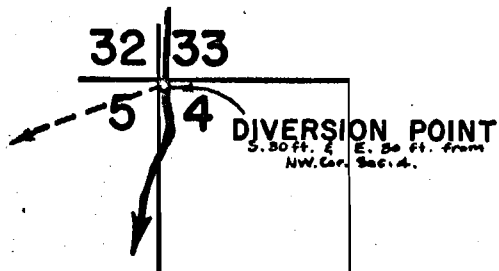

# FINAL PROOF SURVEY

## UNDER

Application No. **34763** Permit No. **27392**  
IN NAME OF

A. E. GARRETT

Surveyed Sept. 17, 1964, by

40-20 ✓