


T.18S. R.6W.W.M.

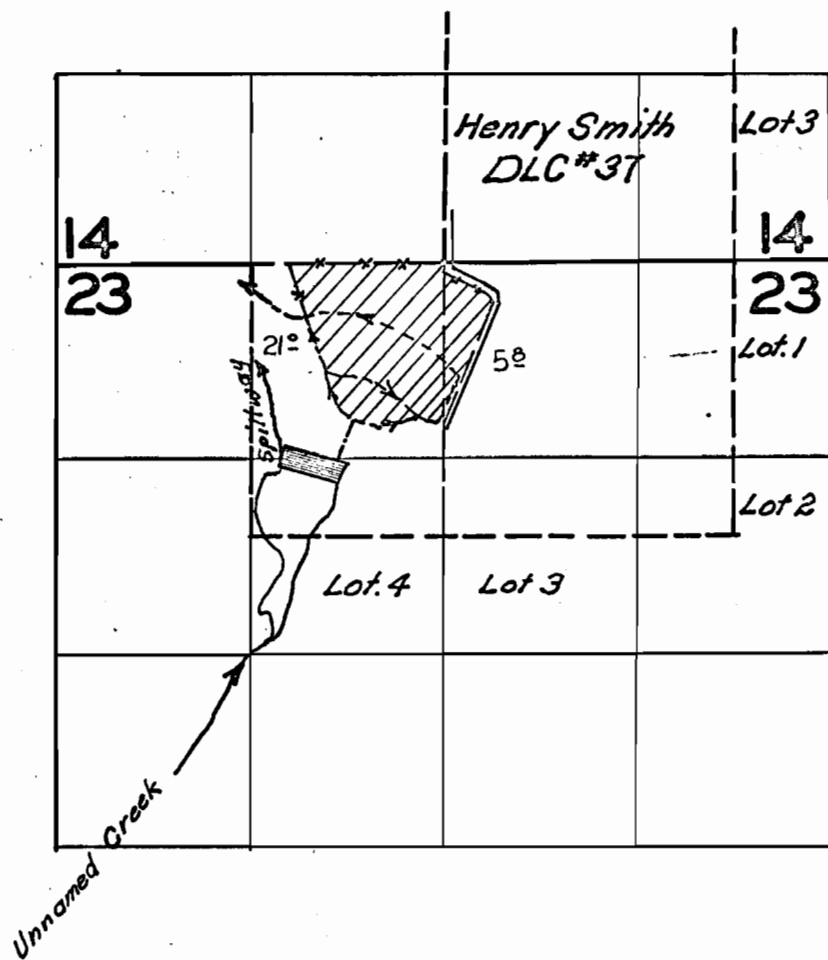

FINAL PROOF SURVEY
UNDER

R-28772 R-1561
Application No. 27267... Permit No. 22555..
IN NAME OF

MARUE C. & CORA A. CARROLL

Surveyed 25 May.. 1962.. by Carl R. Baker.