


T.18S. R.6W.W.M.

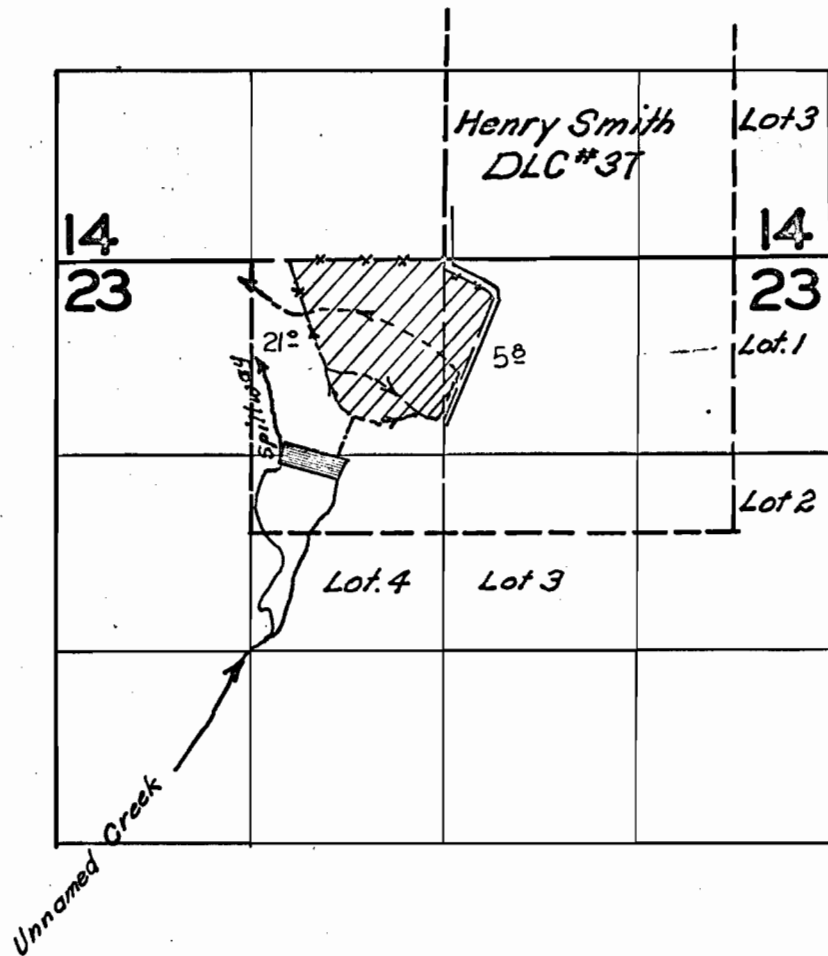

FINAL PROOF SURVEY
UNDER

Application No. *R-28772* 27267... Permit No. *R-1561* 22555..
IN NAME OF

MARUE C. & CORA A. CARROLL

Surveyed *25 May.. 1962..* by *Carl R. Baker..*