


T.21S.R.3 W.W.M.

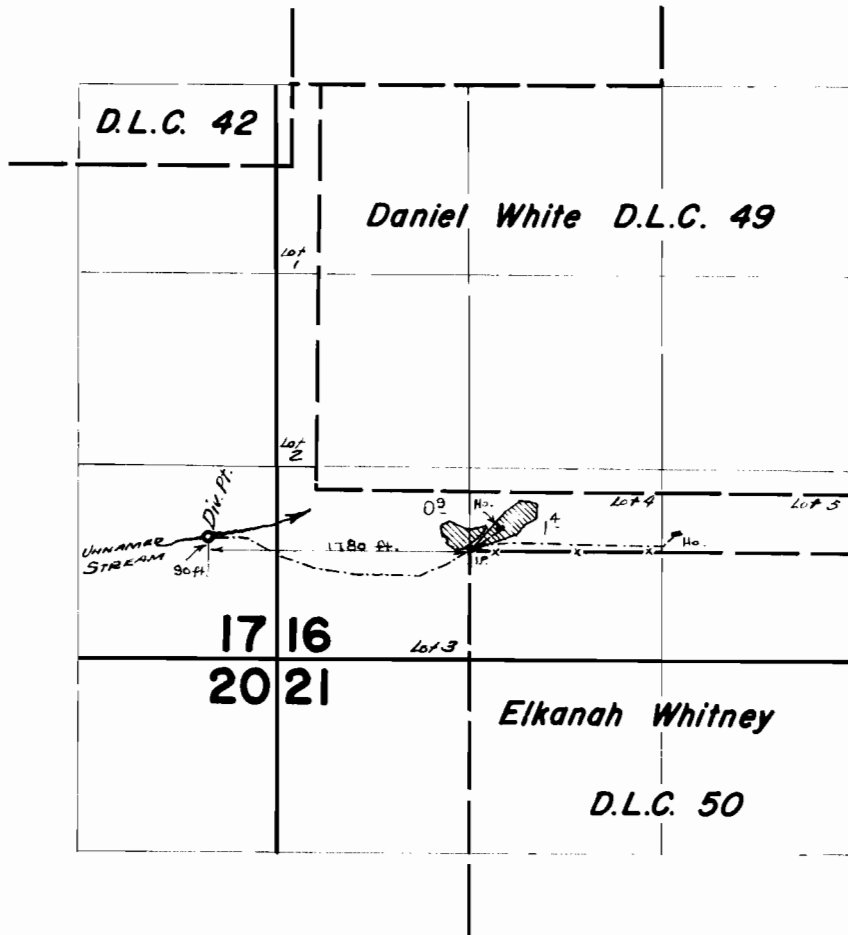

FINAL PROOF SURVEY
UNDER

Application No. 34334 Permit No. 26985
IN NAME OF

E. O. ALLBRITTON & EARL COOPER

Surveyed June 30 1964, by *K. Jackson*