


T.20S.R.1W.W.M.

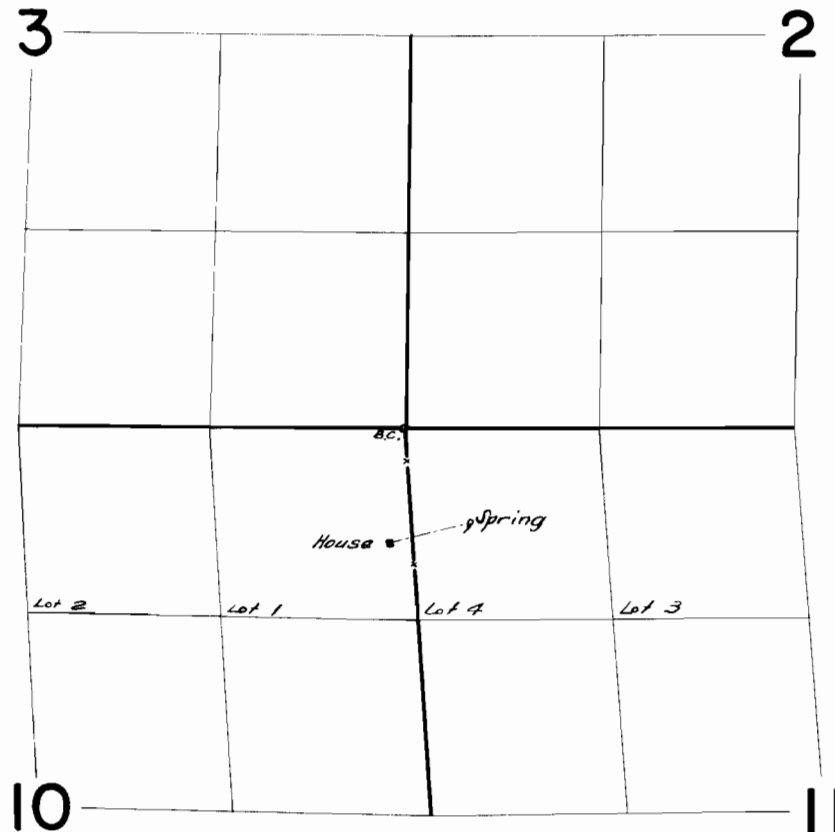

FINAL PROOF SURVEY
UNDER

Application No. **34290** Permit No. **26978**
IN NAME OF

ALEX MCLAUGHLIN

Surveyed May 9, 1963, by C. Baker