


T.17 S. R. 6 W. W.M.

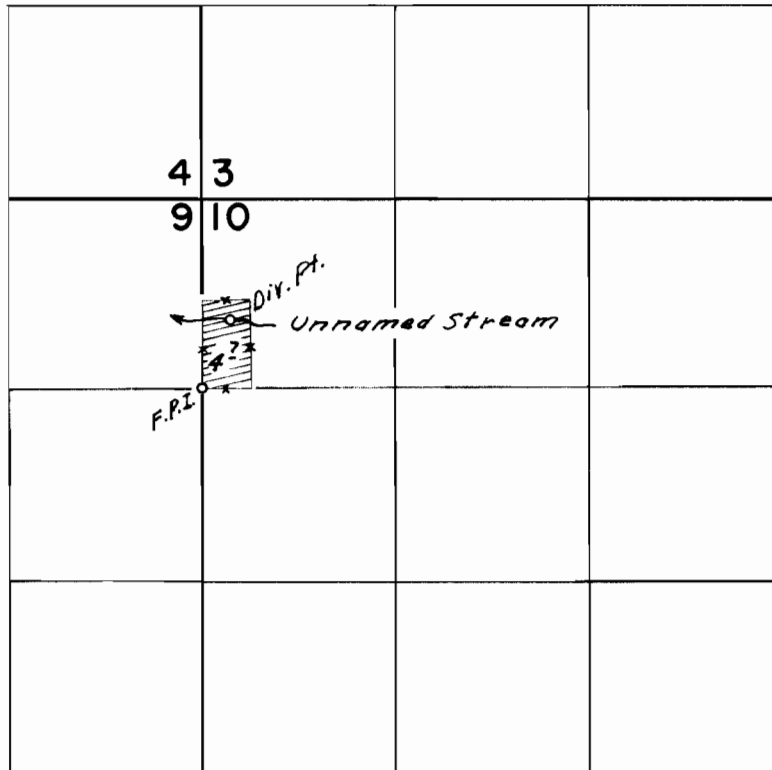

*Diversion Point - 475 ft. N. & 180 ft. E.
from SW Corner NW 1/4 NW 1/4 Section 10*

FINAL PROOF SURVEY
UNDER

Application No. 39636 Permit No. 29452
IN NAME OF

RICHARD W. EASTON

Surveyed *May 5,* 1965, by *Raymond J. Gardner*