


T.8S.R.4W.W.M.

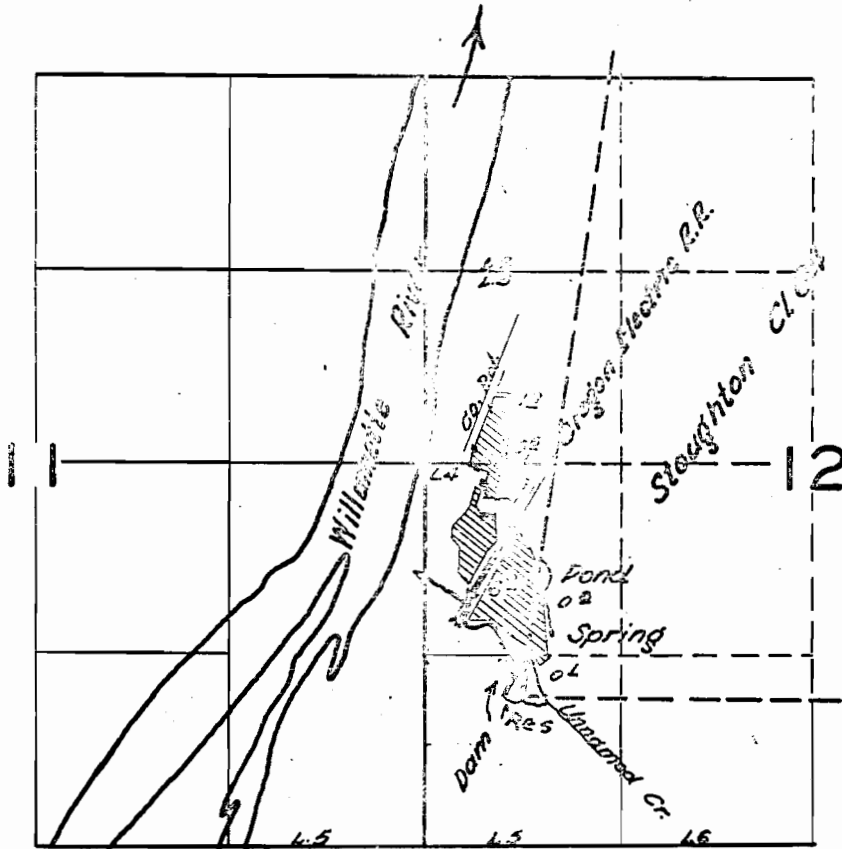

FINAL PROOF SURVEY

UNDER

28428

22464

Application No. ~~R-20358~~ Permit No. R-1522

IN NAME OF

Albert B. & Lenola S. Grissom

Surveyed July 10 1962, by

Phyl L. Sigmund