


T. 5 S. R. 1 W. W. M.

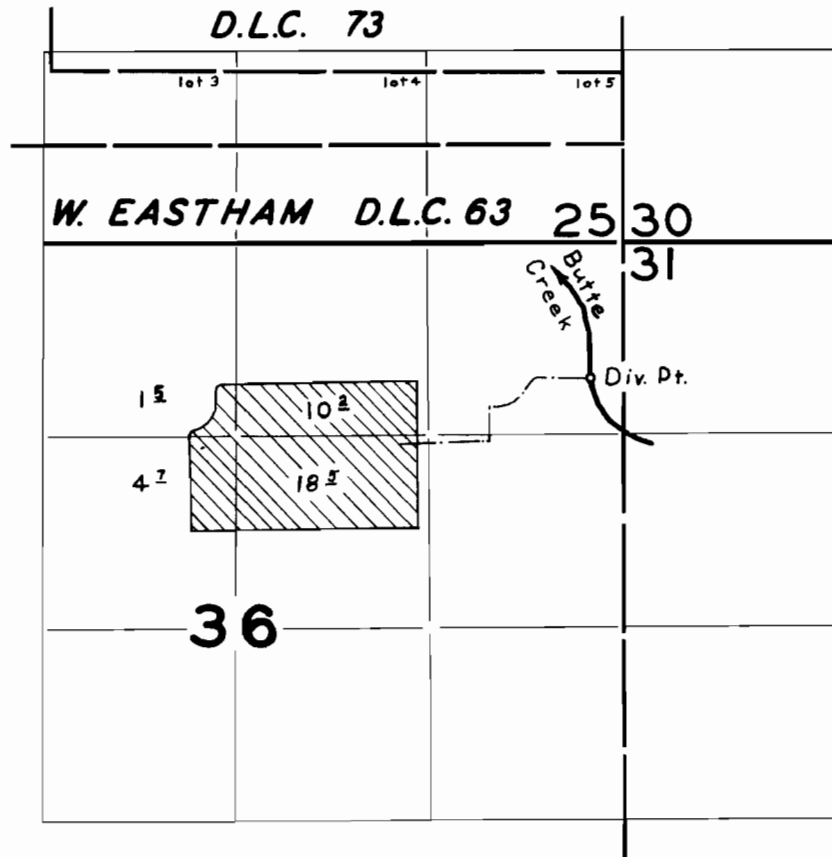

**FINAL PROOF SURVEY**  
UNDER

Application No. 34799 Permit No. 27334  
IN NAME OF

**WALTER DUDA**

Surveyed APR. 7 1964, by R. JACKSON