


T.IN. R.IE. W.M.

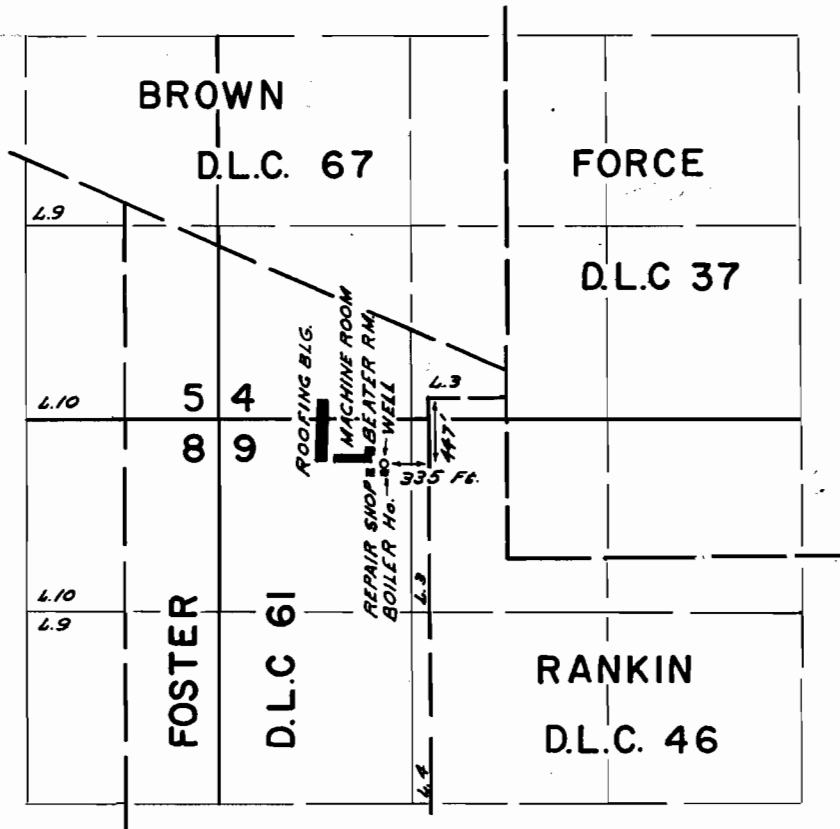

FINAL PROOF SURVEY
UNDER

G-352

Application No. G-325 Permit No. G-242
IN NAME OF

HERBERT MALARKEY

Surveyed OCT. 13 1964, by M. BISH