


T.6S.R.8W.W.M.

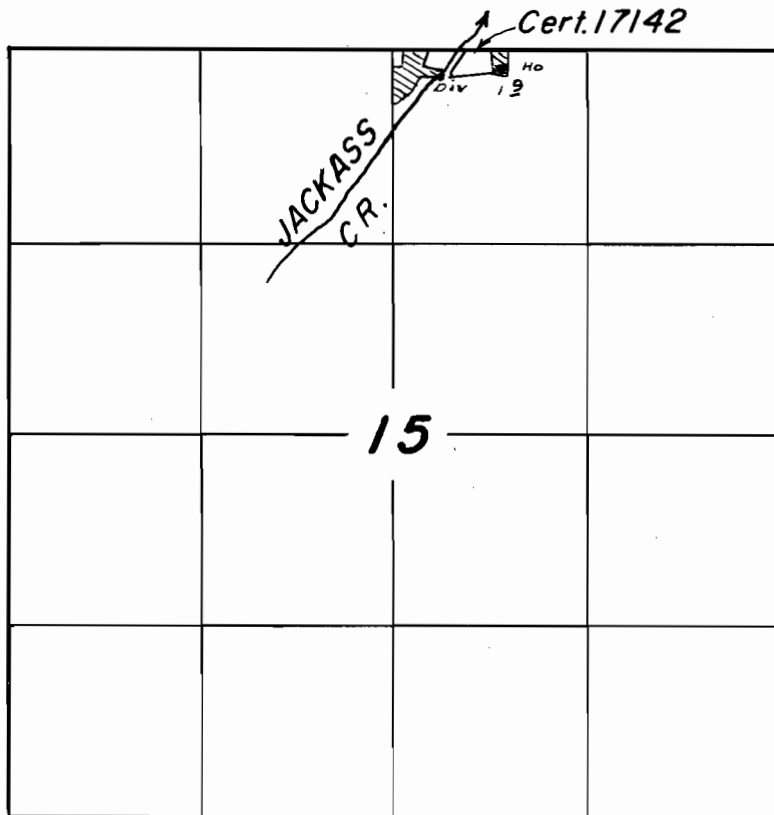

FINAL PROOF SURVEY
UNDER

Application No. 37377 Permit No. 27822
IN NAME OF

Gilbert Smith

Surveyed Oct. 12 1964, by F. Siegmund