


T.2S.R.9W.W.M.

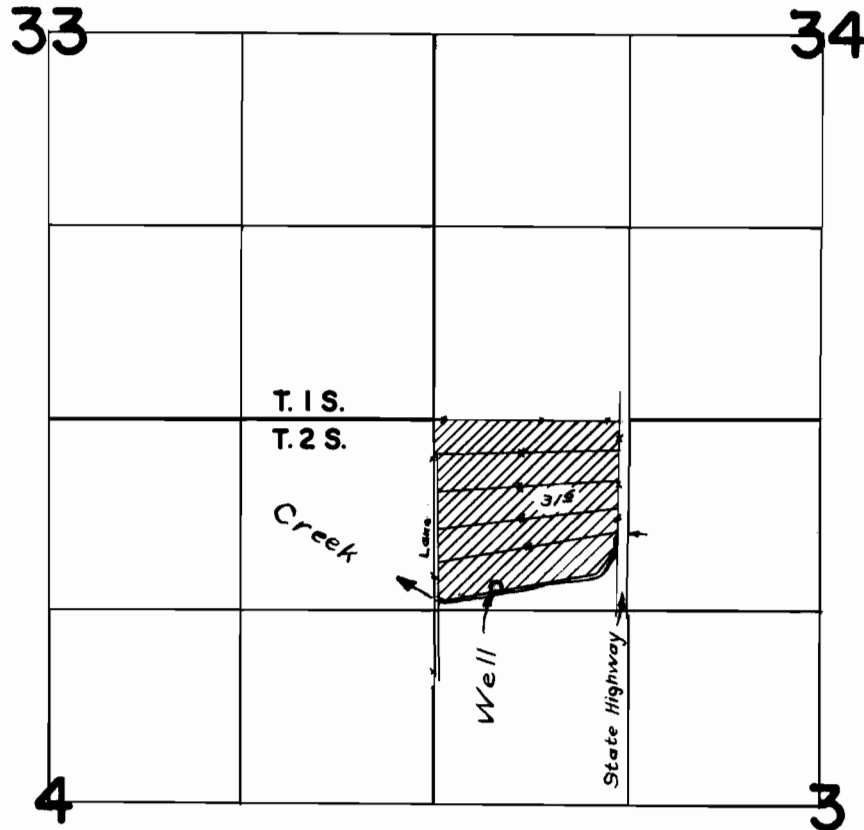

FINAL PROOF SURVEY
UNDER

Application No. G-1811 Permit No. G-1656
IN NAME OF

FRANK A. VOGT

Surveyed May 13 1965, by M. Bish