


T. 2S.R. 9W.W.M.

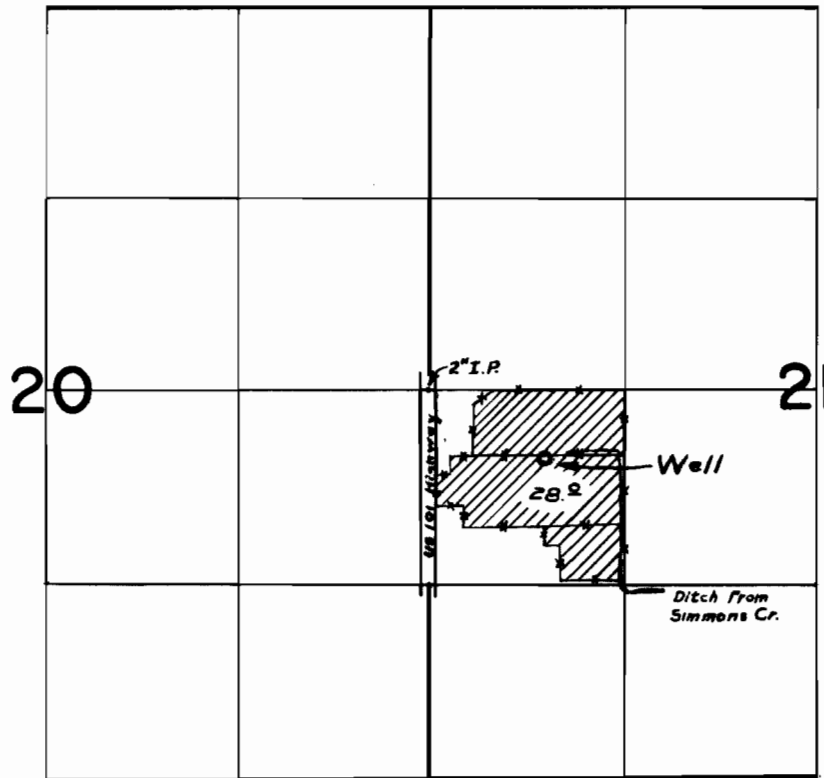

**FINAL PROOF SURVEY  
UNDER**

Application No. G-2155 Permit No. G-1984

**IN NAME OF**

LYLE J. SIMMONS

Surveyed May 14 1965, by M. Bish

1965-1A

*S. L. J.*