


T. 3N. R. 9W. W.M.

SECTION 6

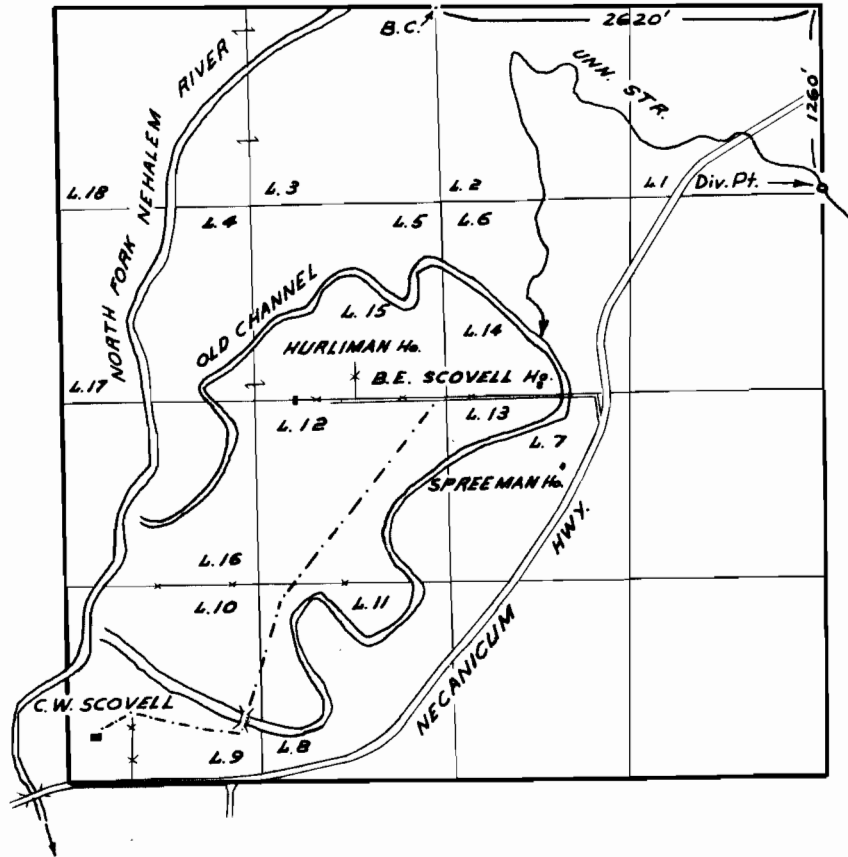

**FINAL PROOF SURVEY**  
UNDER

Application No. 37611 Permit No. 28051  
IN NAME OF

CLIFFORD W. SCOVELL

Surveyed MAY 12, 13 1965, by M. BISH