


T.3S.R.9W.W.M.

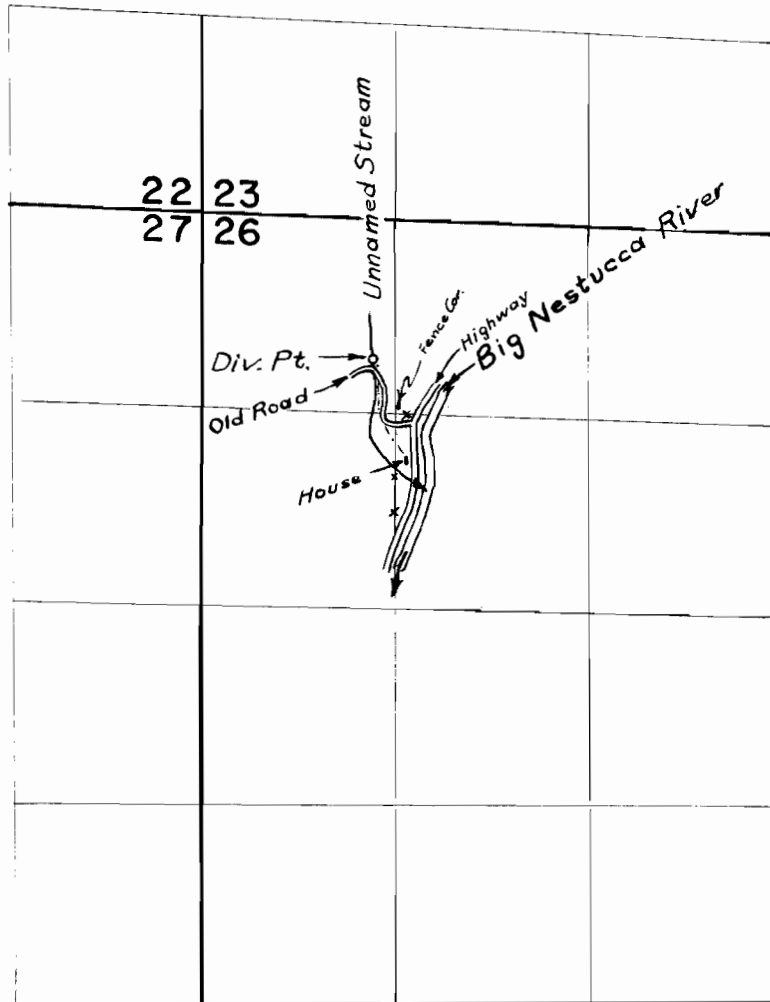

FINAL PROOF SURVEY
UNDER

Application No. 38678. Permit No. 28779.
IN NAME OF

RALPH W. PIEREN

Surveyed June 10, 1964, by M. Bish