


# T. 4S. R. 10W. W.M.

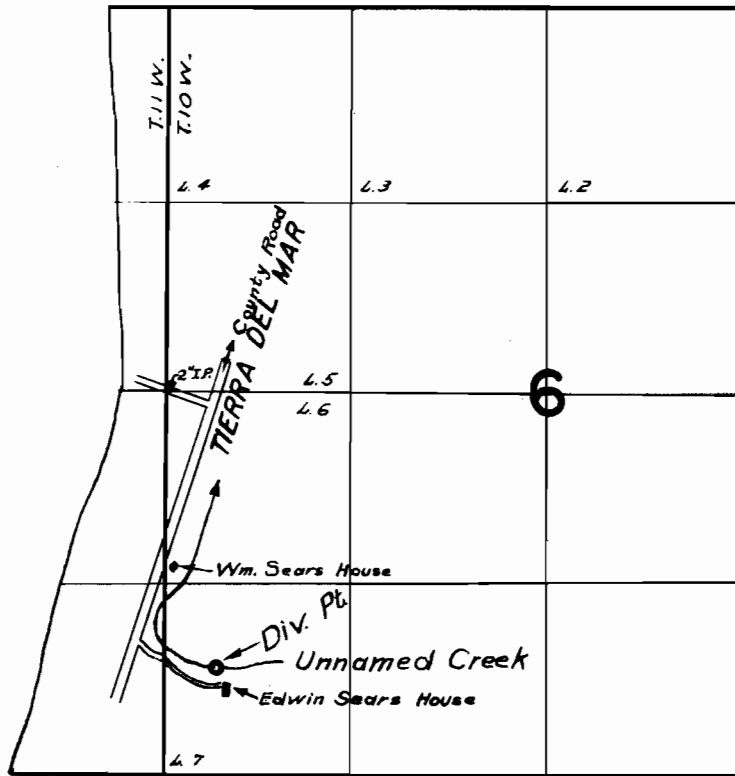

## FINAL PROOF SURVEY UNDER

Transfer No. S-161 For EDWIN G. SEARS

Application No. 39262 Permit No. 29245  
IN NAME OF

WILLIAM G. SEARS

Surveyed May 14 1965, by M. Bish