


SURVEYOR'S CERTIFICATE

I, W. E. ANDERSON OF TILLAMOOK, OREGON DO HEREBY CERTIFY THAT THIS MAP WAS MADE FROM NOTES TAKEN DURING AN ACTUAL SURVEY MADE BY ME IN SEPTEMBER 1963, AND THAT IT CORRECTLY REPRESENTS THE WORK HEREIN

COUNTY SURVEYOR

W. E. Anderson

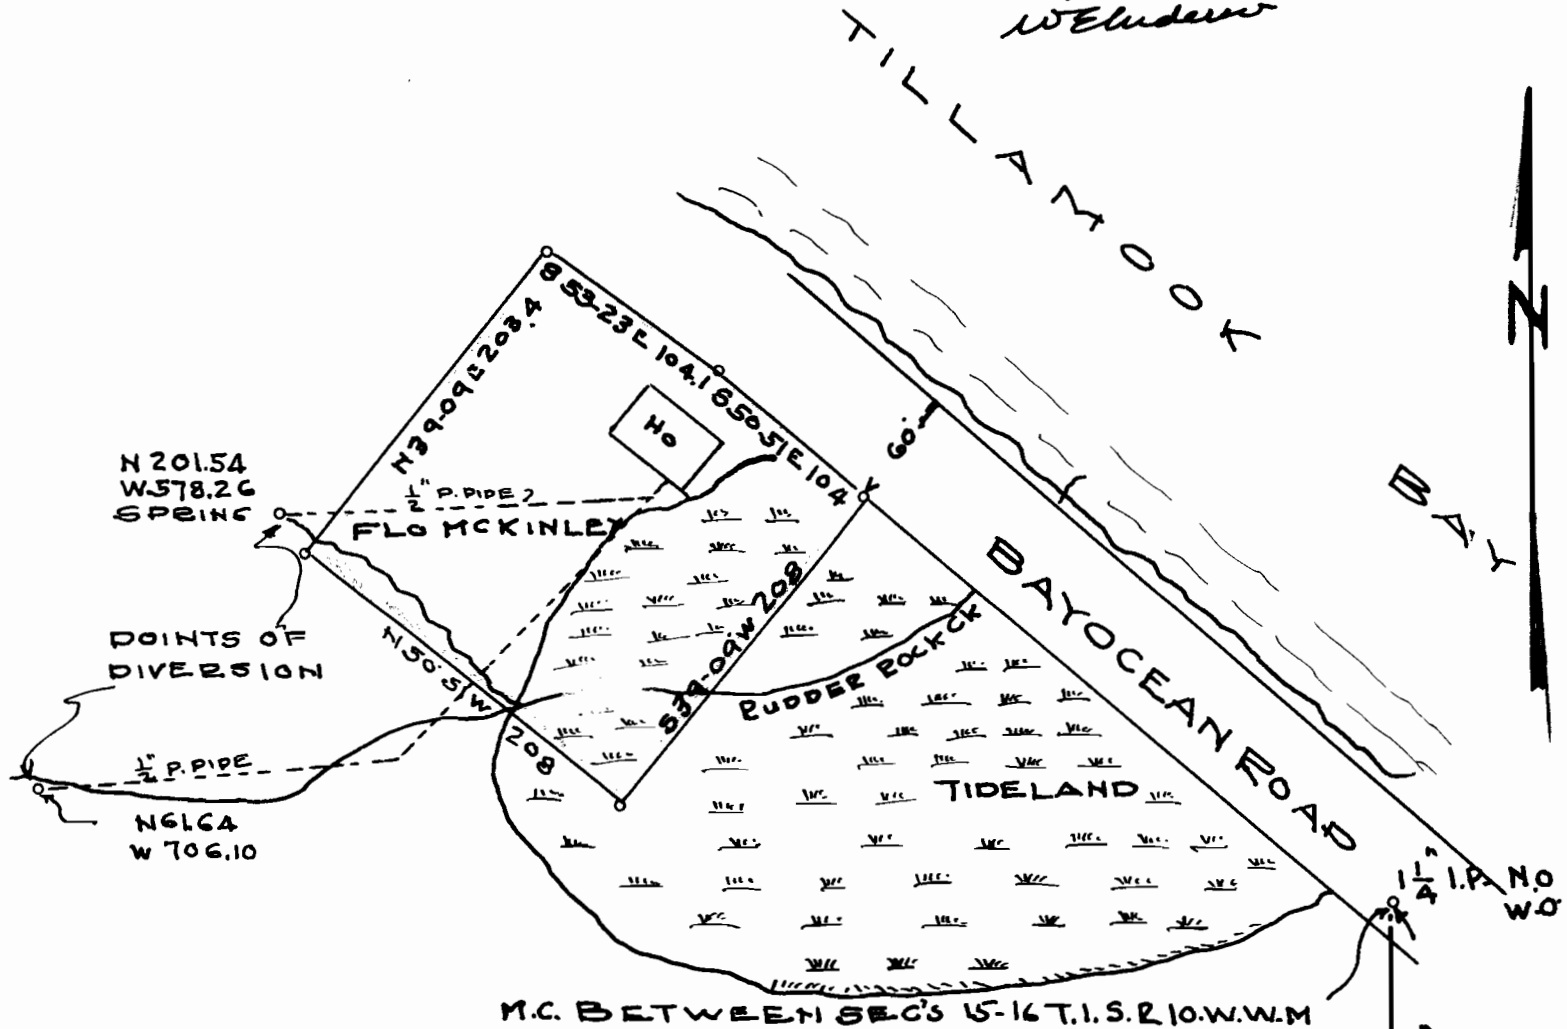

M.C. BETWEEN SEC'S 15-16 T.1.S. R.10.W.W.M

Application No. 39510
Permit No. 29401

CROWN ZELLERBACH
GOVT LOT 3

MRS H.E. MCKINLEY WATER RIGHT
IN GOVT LOT 3, SEC 16 TWP. 1.S. R. 10.W.W.M
TILLAMOOK COUNTY OREGON SCALE 1"=100'

16 15
21 22

NORTH 2227.5

W. E. Anderson