


T.I.S.R.8W.W.M.

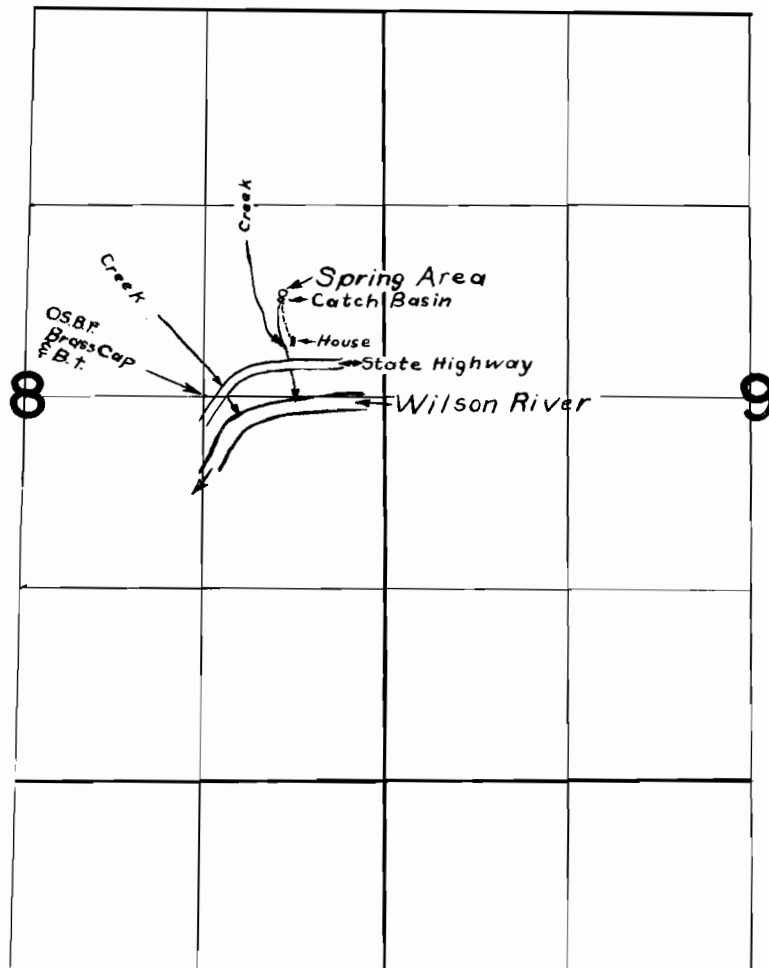

FINAL PROOF SURVEY
UNDER

Application No. **39684** Permit No. **29534**
IN NAME OF

ORT C. and NORENE L BASTIAN

Surveyed **May 11 1965**, by **M. Bish**