


T.3N. R.9W.W.M.

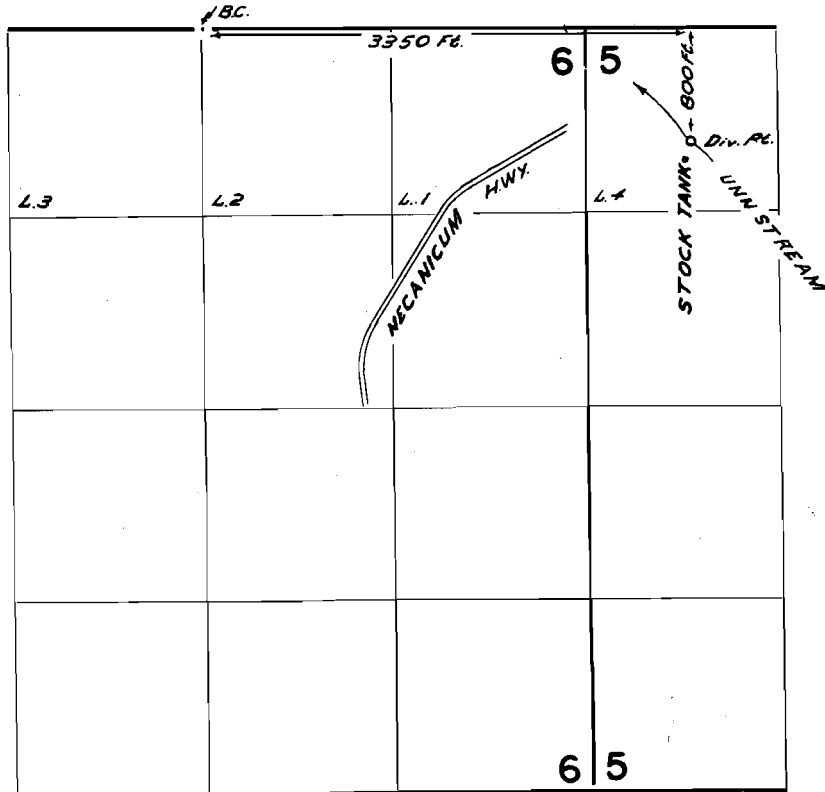


**FINAL PROOF SURVEY
UNDER**

Application No. 39875 Permit No. 29834
IN NAME OF

ANDREW A. LAGLER

Sureyed May 13 1965, by M. Bish

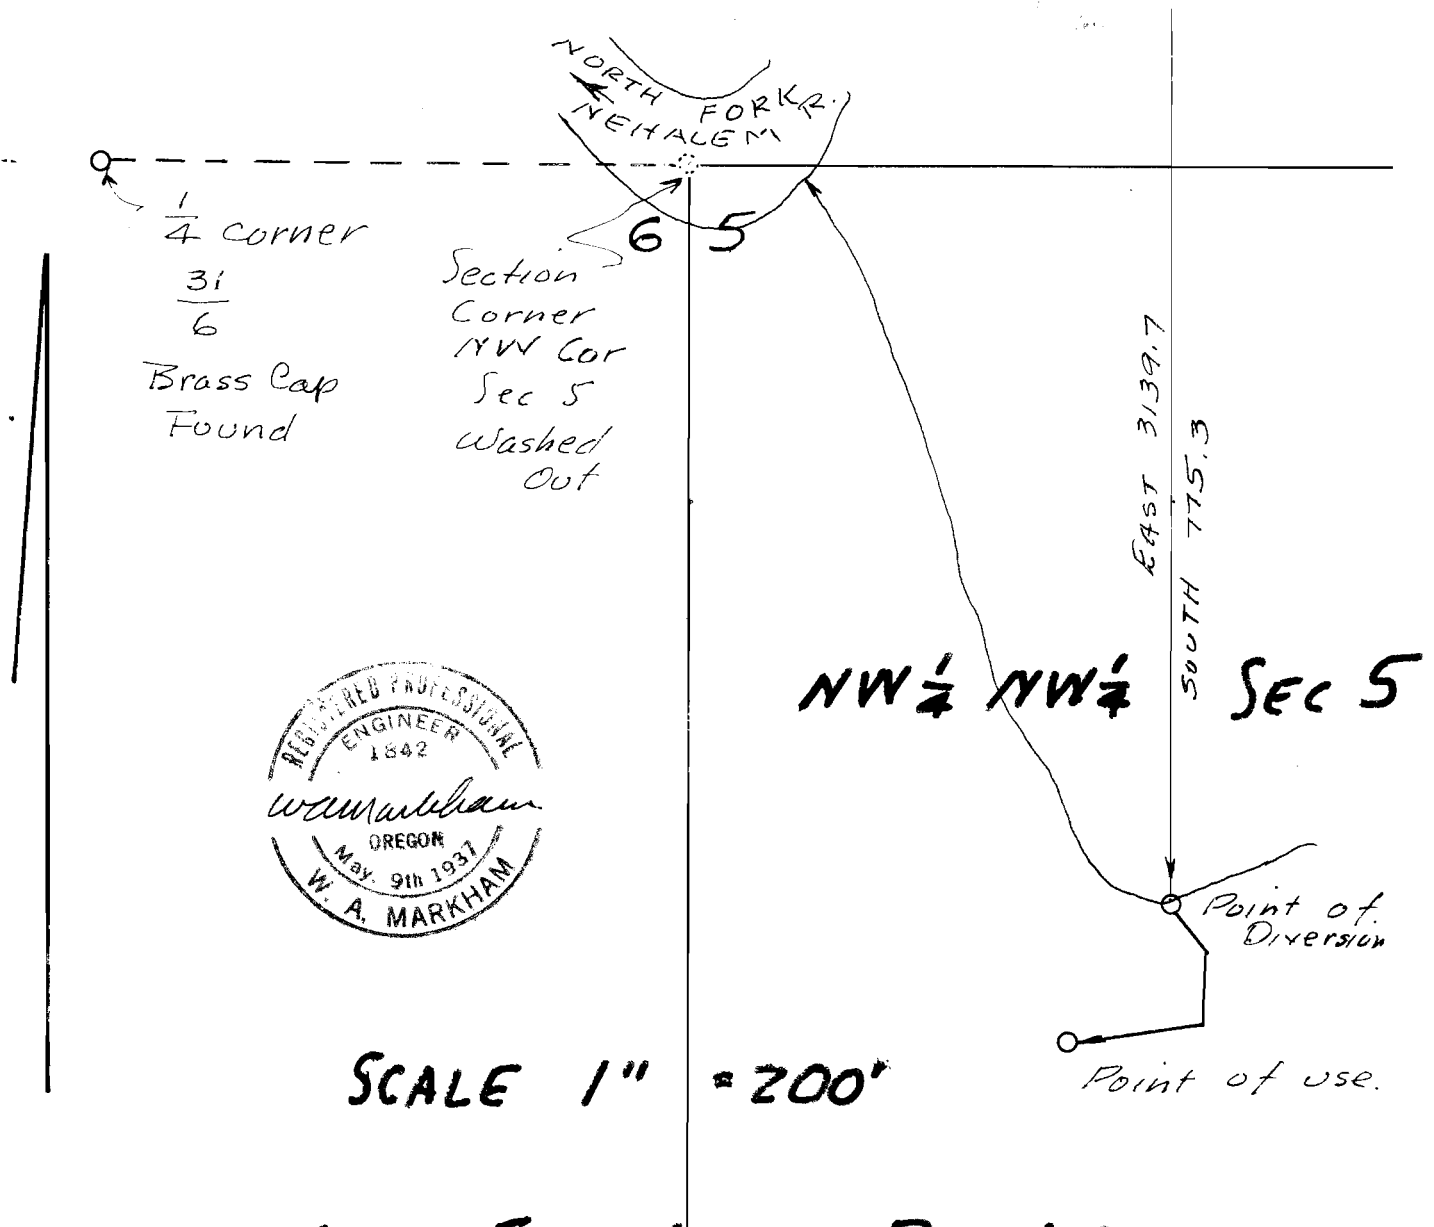

MAP FOR WATER RIGHT ANDREW LAGLER NW 1/4 NW 1/4 SEC 5, T3N R9W

I, W. A. Markham, of Arch Cape Oregon do hereby certify that this map is made from notes of an actual survey made by me on May 11, 1964.

W. A. Markham.
Reg. Engr. No 1842.

Application No 39875
Permit No 29834