


Roll 7 76-397
33206

T.6N. R.35E. W.M.

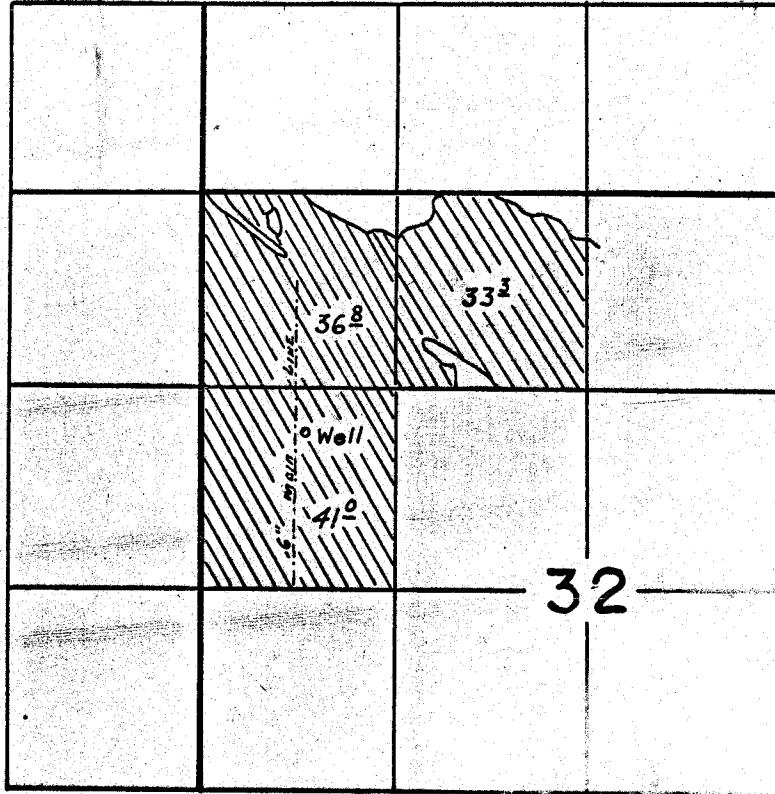

FINAL PROOF SURVEY ORDER

Application No. 24997 Permit No. G-267
NAME OF

GEORGE W. REES WILLIAMS

Surveyed May 19 1966 by W. H. H. H.