


T.3S.R.38E.W.M.

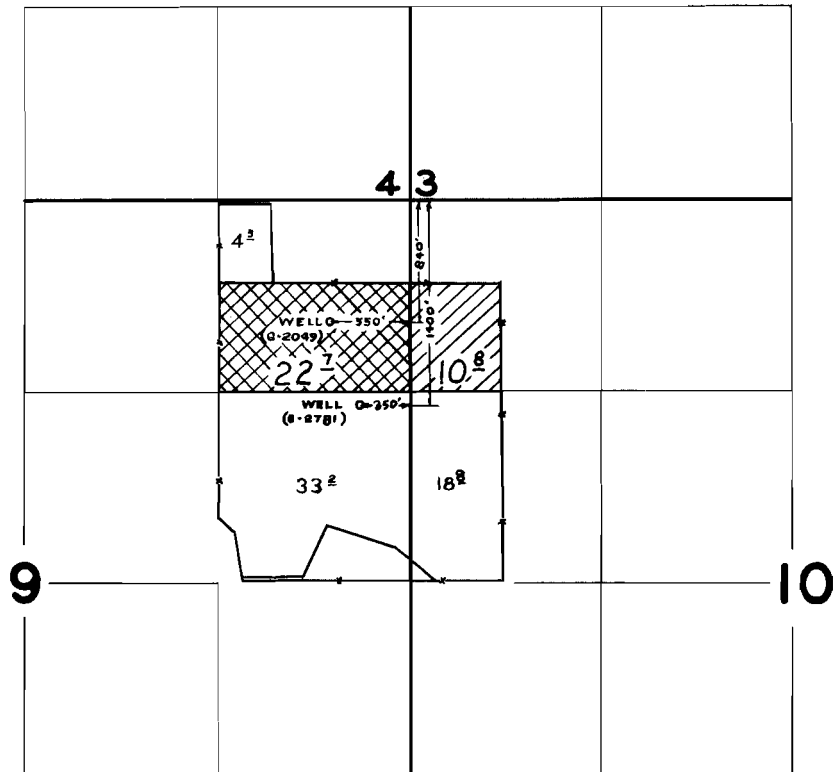

APPL. No. G-2049



APPL. No. G-2781

FINAL PROOF SURVEY UNDER

Application No. G-2049 Permit No. G-1896
G-2781 G-2579

IN NAME OF
**CHURCH OF JESUS CHRIST OF
 LATTER DAY SAINTS**

Surveyed Nov. 4 1965, by C. GARDNER