


T. 1 S. R. 2 W. W. M.

E-5297 100

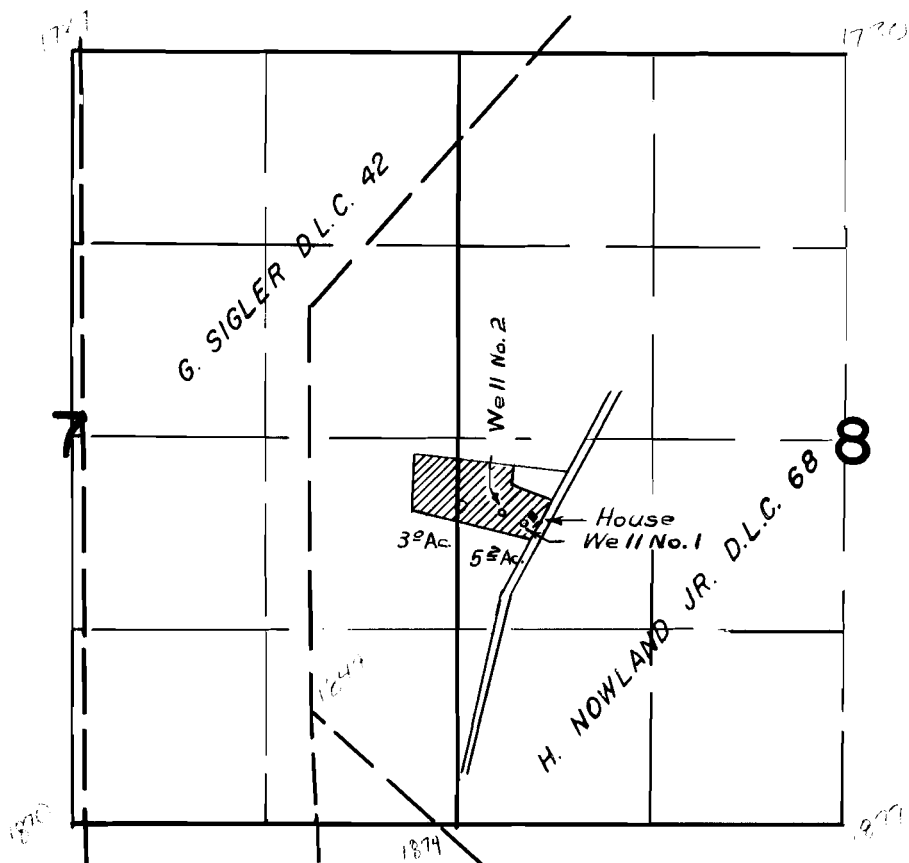

FINAL PROOF SURVEY UNDER

Application No. G-1945 Permit No. G-1788
IN NAME OF

GLEN WALTERS

Surveyed April 27 1964, by M. Bish