


T. 2 S. R. 2 W. W. M.

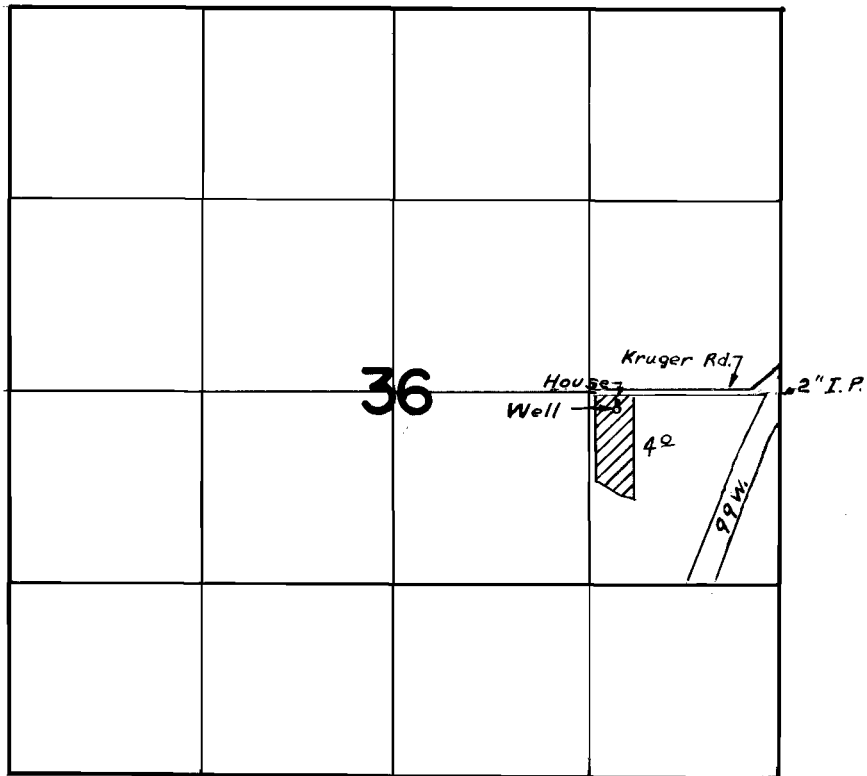

FINAL PROOF SURVEY
UNDER

Application No. G-1952 Permit No. G-1794
IN NAME OF

RONALD ELSNER

Surveyed May 25 1961, by M. Bish