


# T. IN. R. IW. W. M.

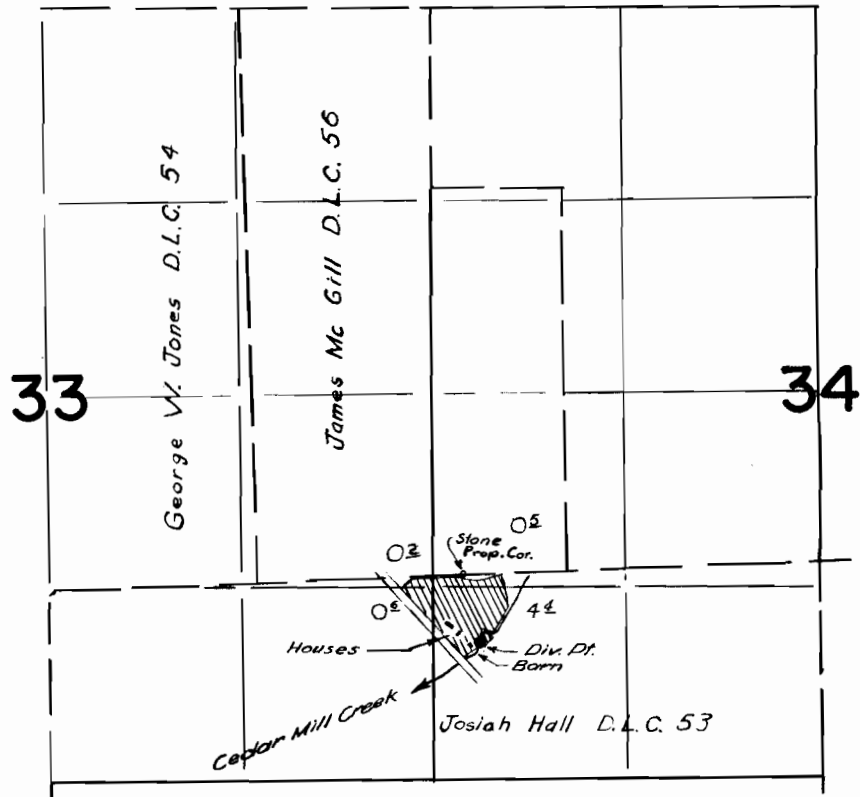

## FINAL PROOF SURVEY UNDER

Application No. 34450 Permit No. 27065  
IN NAME OF

FRANK SAMUEL CRANER

Surveyed May 14 1964, by M. Bish