


T.1N.R.4W.W.M.

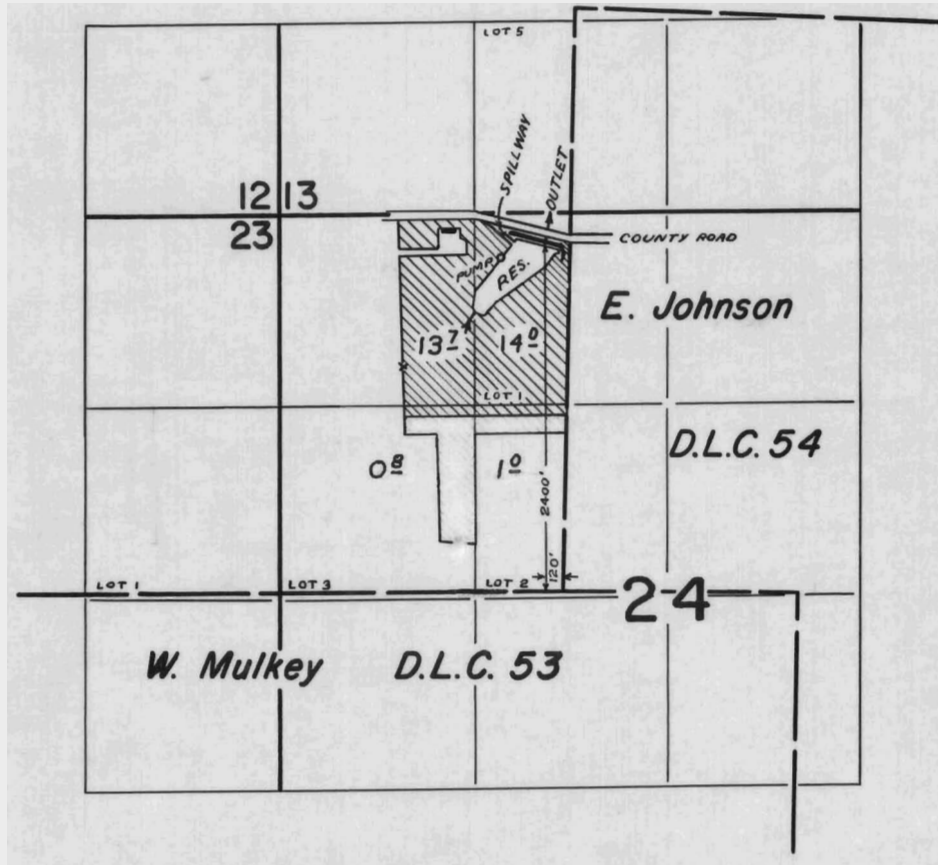

FINAL PROOF SURVEY
UNDER

R-37022 R-2647
Application No. 37023 Permit No. 27512
IN NAME OF

WILFRED PETERS

Surveyed May 25 1965, by M. BISH