


T. 2 S. R. 1 W. W.M.

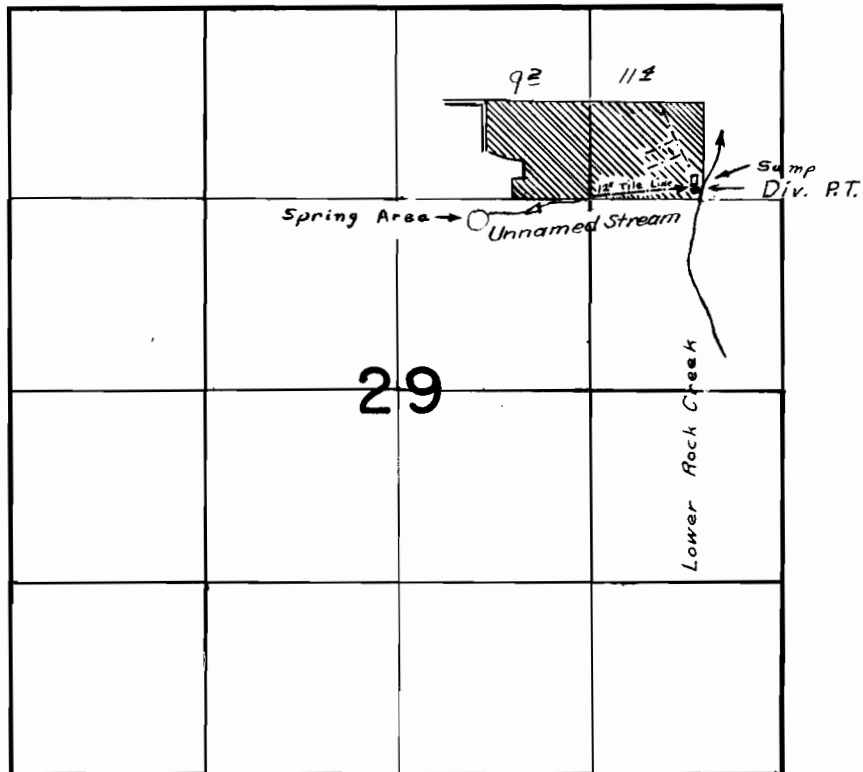

FINAL PROOF SURVEY
UNDER

Application No. 37221 Permit No. 27738
IN NAME OF

..... WILLIAM OLDENBURG

Surveyed May 25, 1964, by M. Bish.....