


T. I. S. R. 4 W. W. M.

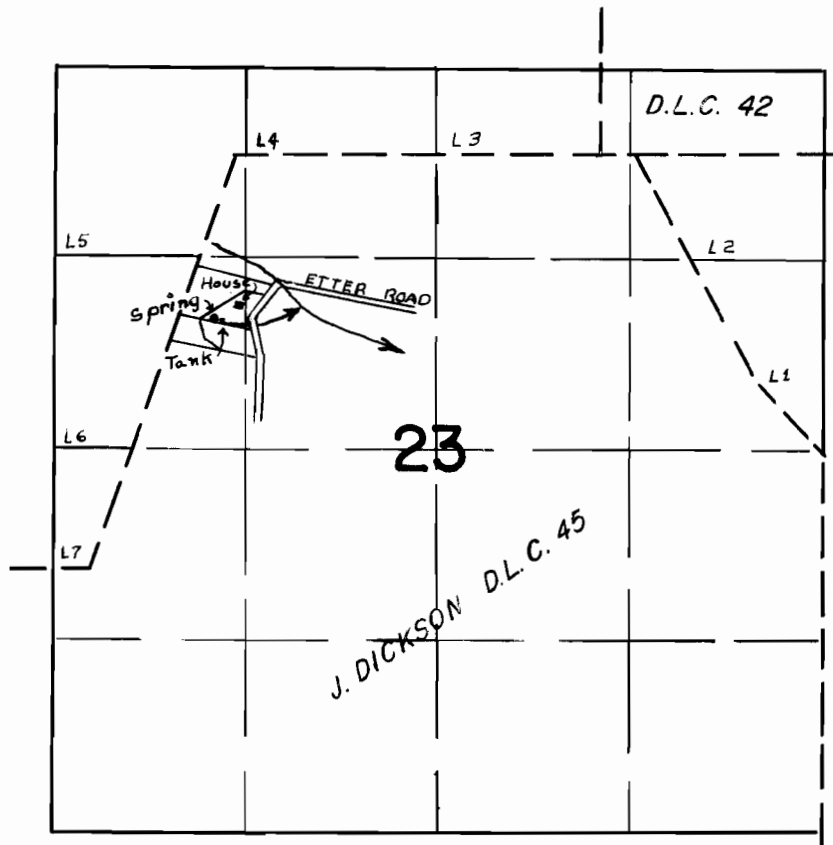

FINAL PROOF SURVEY
UNDER

Application No. 38285 Permit No. 2 8519.
IN NAME OF

WILLIAM ARNOLD SUNDERMEIER

Surveyed April 15 1964., by M. Bish.....