


T. 1 S. R. 3 W. W.M.

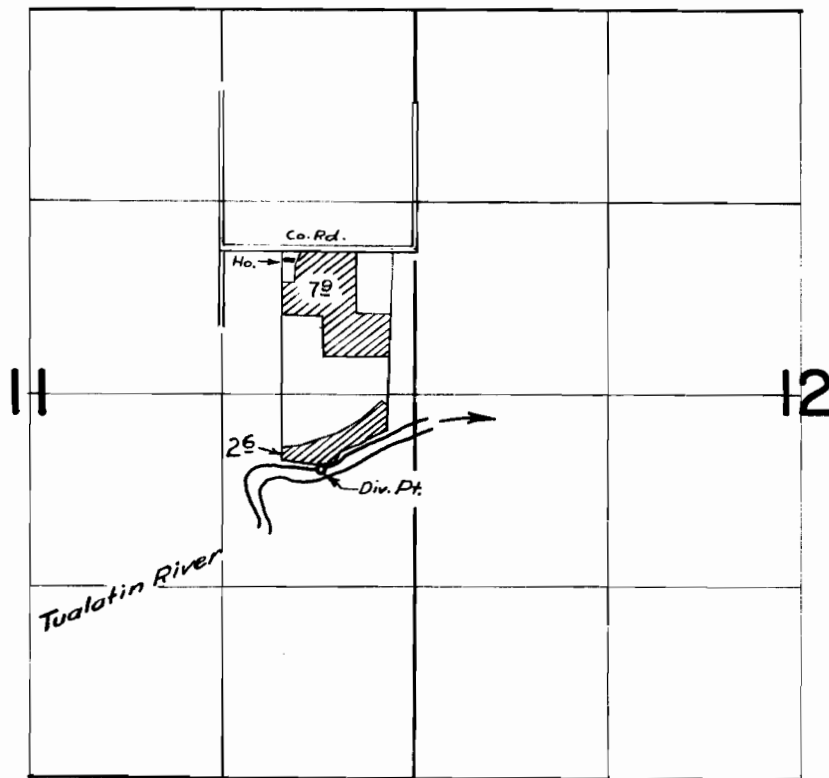

**FINAL PROOF SURVEY**  
UNDER

Application No. 38324 Permit No. 28532  
IN NAME OF

WESLEY BRYAN

Surveyed April 27 1964, by T. Bish