


T.2N. R.5W. W.M.

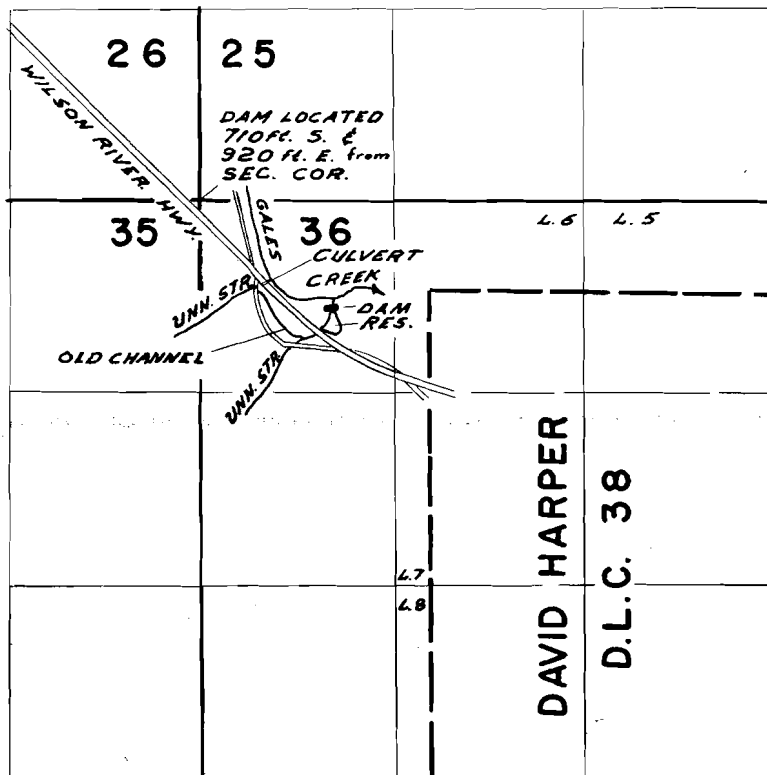

FINAL PROOF SURVEY
UNDER

R-40249

R-4498

Application No. 40334 Permit No. 30033
IN NAME OF

THOMAS E. TAYLOR

Surveyed MAY 22 1965, by M. BISH