


T.5S.R.3W.W.M.

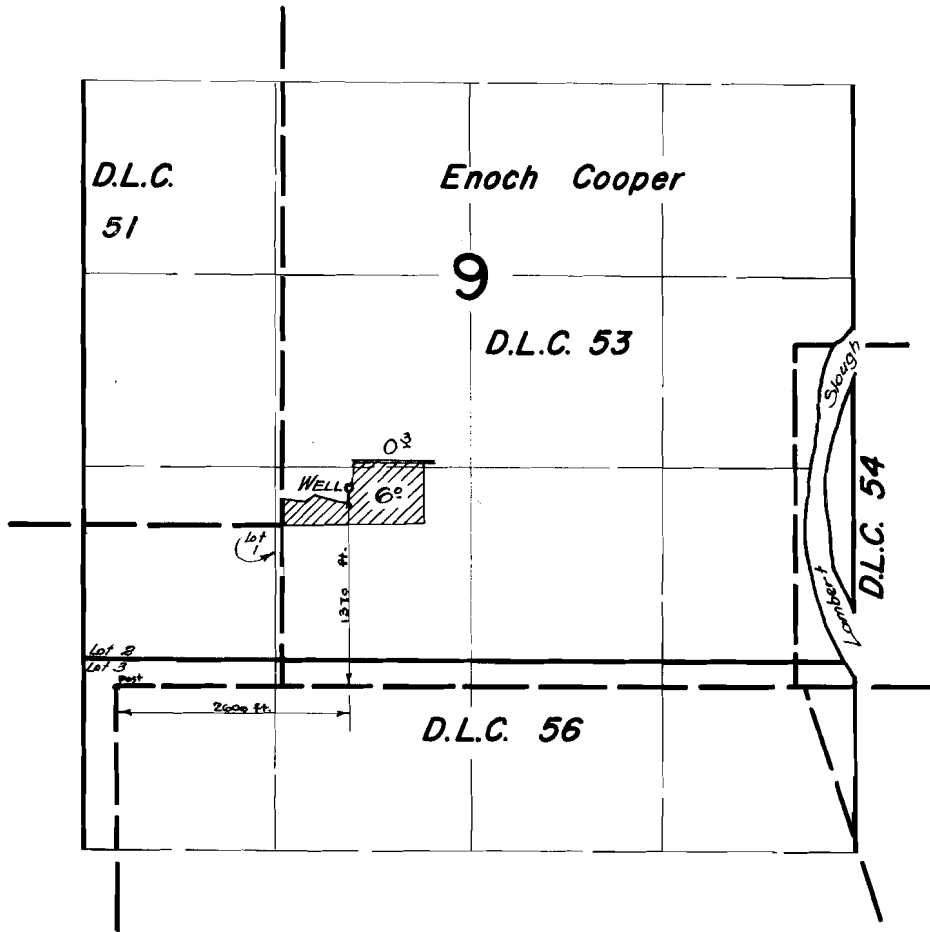

FINAL PROOF SURVEY
UNDER

Application No. G-2047. Permit No. G-1881.....
IN NAME OF

ROBERT E. RUYLE

Surveyed August 4, 1964, by *[Signature]*