


T. 4 S. R. 6 W. W. M.

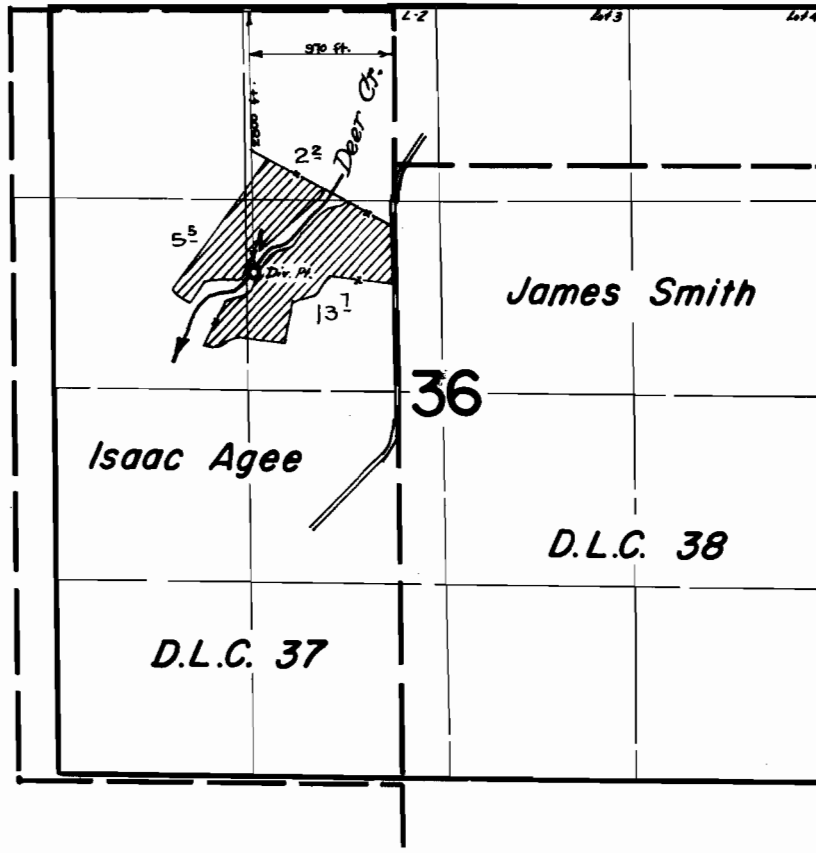

FINAL PROOF SURVEY
UNDER

Application No. 32800 Permit No. 25876
IN NAME OF

E. HOWARD & MARGARET NIELSEN

Surveyed August 26 1964, by [Signature]