


T.4S.R.4W.W.M.

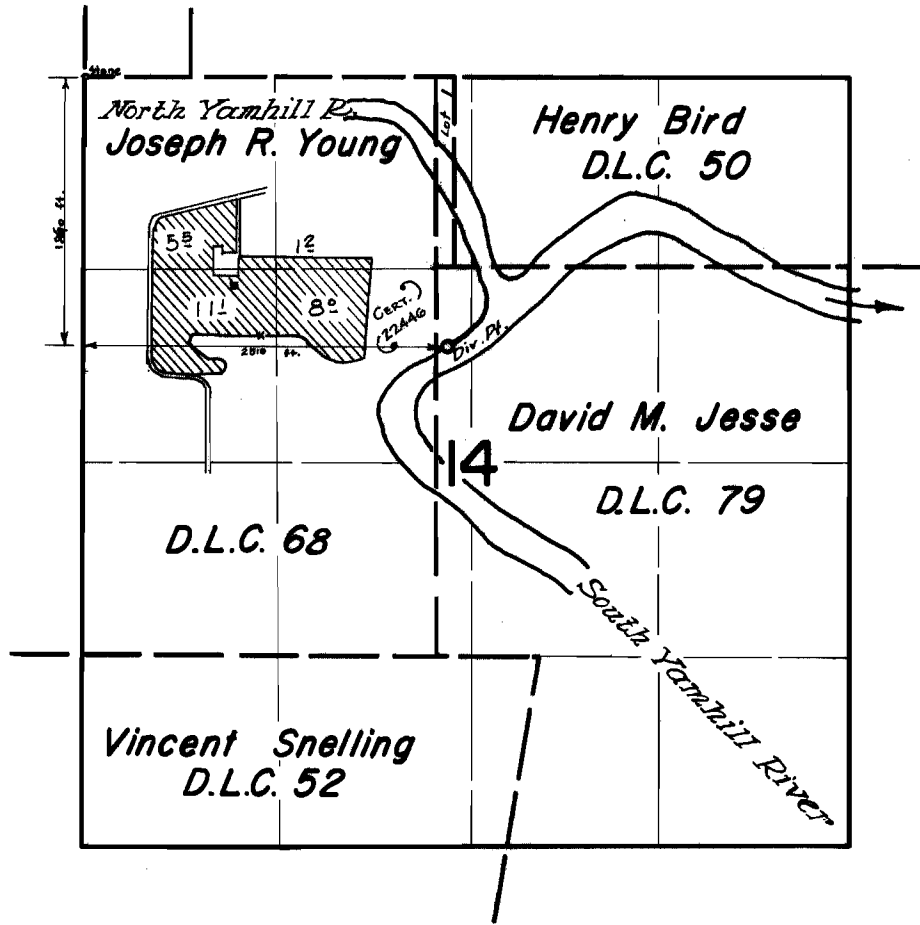

FINAL PROOF SURVEY
UNDER

Application No. 33001... Permit No. 26181...
IN NAME OF

H. J. ROEDEL

Surveyed August 25 1964, by *[Signature]*